

LAND CORNER RECORDATION CERTIFICATE

FILING REQUIREMENT OF ACT 74, MICH. P.A. 1970

Washfenaw Co.

FOR CORNERS OF --:	LOCATED IN --:	CORNER CODE NUMBER
1. PUBLIC LAND SURVEY <u>12</u> T. <u>1</u> S., R. <u>3</u> E.		<u>K-3, L-3</u>
2. PROPERTY CONTROLLING IN SECTION _____, T. _____, S., R. _____ E.	N. _____ E.	
3. MISCELLANEOUS PROPERTY IN SECTION _____, T. _____, S., R. _____ E.	N. _____ E.	
4. LOT NO. _____, RECORDED PLAT _____		
5. PRIVATE CLAIMS _____		

REGISTER OF DEEDS STAMP AND FILING NUMBER

I, Donald L. Bissell, do hereby certify that under requirements of P.A. 74, Michigan P.A. of 1970, the corner points mentioned in lines 1 and 2 above were, in a field survey on March, 1987, established, re-established, monumented, re-monumented, recovered or restored as expressed below and in conformance with regulations and rules therefore as required in the current manual of survey instructions of the United States Department of the Interior, Bureau of Land Management or by a decree of a court of law. Furthermore, that the corner points mentioned in lines 3, 4 and 5 above were, in a field survey on _____, 19____, found, recovered, restored, established or re-established as expressed below and in conformance with the rules of the Michigan State Board of Registration for Land Surveyors or, by a Decree of a Court of law:

A. Description of original monument and accessories and/or subsequent restoration:

B. Description of corner evidence found and/or method applied in restoring or re-establishing corner:

K-3 NW Corner Section 12 Found 1" Iron Pipe S78°E-61.6'-12" Maple N72°W-83.65'-30" Oak N & S-33.00'-Iron Pipe @ ROW Southerly-38.2'-Power Pole Northerly-5.1'-3/8" x 3" Strap Iron Witness from C. Wilson	L-3 N 1/4 Corner Section 12 Set 4" x 36" Concrete Monument with aluminum cap M.P.O.L.
--	--

C. Description of monument for corner and accessories established to perpetuate locating the position of the corner:

K-3 NW Corner Section 12 1" Iron Pipe S78°E-61.6'-12" Maple N72°W-83.65'-30" Oak N & S-33.00'-Iron Pipes (ROW) Southerly-38.2'-Power Pole Northerly-5.1'-3/8 x 3" Strap Iron	L-3 N 1/4 Corner Section 12 4" x 36" Concrete Monument with aluminum cap. N35°W-34.46'-4" Oak S81°W-42.22'-14" Apple Tree N57°E-25.49'-5" Oak S62°W-24.13'-6" Oak
--	---


SIGNED BY _____ DATE _____

SURVEYOR'S MICHIGAN REGISTRATION NO. _____

FOR STATE AND UNITED STATES AGENCIES:

SIGNED BY _____ DATE _____

APPROVED AND SIGNED BY Donald L. Bissell DATE 9-25-87
CHIEF OF SURVEY PART
MICHIGAN REGISTERED LAND SURVEYOR

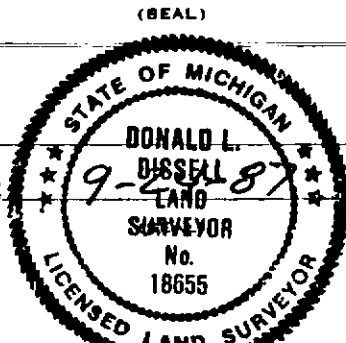

SURVEYOR'S MICHIGAN REGISTRATION NO. 18655