

SURVEY &
REMONUMENTATION

LAND CORNER RECORDATION CERTIFICATE
Filing Requirement of Act 74, Mich, P.A. 1970

NOV 02 1999

SECTION

For corner in

Washtenaw
(County)

Located in:

Corner Code #

- | | | | | | |
|------------------------------------|---|-----------|---|-----------|------------|
| 1. Public Land Survey | T | <u>1S</u> | R | <u>3E</u> | <u>L-5</u> |
| | T | | R | | |
| | T | | R | | |
| | T | | R | | |
| 2. Property Controlling in Section | S | | T | | |
| | S | | T | | |
| 3. Miscellaneous Property in Sec | S | | T | | |
| | S | | T | | |



5017324
Page: 1 of 2
02/25/1999 02:59P
L-2 P-212

Peggy M. Haines - Washtenaw Co. CORREM
copy Register of Deeds Stamp & File Number

4. Lot No. _____, Recorded Plat _____
5. Private Claims _____

I, Charles C. Wilson, in a field survey on June, 19 98, do hereby certify that under requirements of P.A. 74, Michigan P.A. of 1970, the corner points mentioned in lines 1 and 2 above were in conformance with regulations and rules therefore as required in the current manual of survey instruction of the United States Department of the interior, Bureau of Land Management or by a decree of a Court of Law and/or that the corner points mentioned in lines 3, 4 and 5 above were in conformance with the rules of the Michigan Board of Land Surveyors or by a Decree of a Court of Law; established, re-established, monumented, re-monumented, recovered, found as expressed below.

	A	B	C	D	E	F	G	H	I	J	K	L	M
1													
2	6	5	4	3	2	1							
3													
4	7	8	9	10	11	12							
5													
6	18	17	16	15	14	13							
7													
8	19	20	21	22	23	24							
9													
10	30	29	28	27	26	25							
11													
12	31	32	33	34	35	36							
13													

NOTE: Not more than 4 corners, all in the same town and range, may be recorded on this certificate.

A. Description of original monument and accessories and/or subsequent restoration:

- United States Government Survey, 1815 Instructions, Surveyed 1825
- Bearing Trees A) B. Oak 9" N29deg.W 17.16
- B) B. Oak 18" N71deg.E 31.02


Continued on Back

B. Description of corner evidence found and/or method applied in restoring or reestablishing corner:

Found 1-3/4" Iron Pipe in Concrete Base, 10" below ground surface. Raised with 3/4" x 18" Iron Pipe with Remonumentation Cap Stamped #13604 to ground surface.

C. Description of monument for corner and accessories established to perpetuate locating the position of the corner:

- 3/4" x 18" Iron Pipe with Remonumentation Cap Stamp #13604 (to ground surface)
- 3) 15" Elm N45deg.E 94.60 (Nail & RT SE/S)
- 4) 38" Willow N60deg.E 79.60 (Nail & RT S/S)
- 5) Utility Pole E'ly 50.78 (Nail N/S)
- 6) Telephone Pole N80deg.W 58.24 (Nail N/S)
- 7) 28" Pine N84deg.E 65.78 (Nail & RT S/S)
- 8) 26" Pine S85deg.E 67.00 (Nail & RT S/S)
- 19" Elm N50deg.W 60.90 (Nail SW/S)

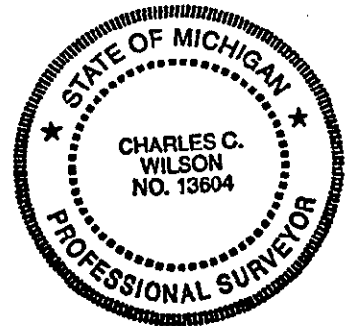

I feel that this point should be accepted as the best available evidence of the position of the original corner.

This corner was ratified by the Peer Committee on August 10, 1998

Signed by Charles C. Wilson
Surveyors Michigan's License No. 13604

Date August 10, 1998

APPROVED
DATE 8-10-98
CO. REP. [Signature]

COPY

NOV 02 1999

SECTION

L-5

Paragraph A Continued:

Washtenaw County Road Commission, W.J. Armstrong, PLS#2444, June 1934
WCRC Grid Book, Found Iron Pipe in Concrete at Fence Intersection
20' N of Lake.

1) 6" Poplar S20deg.E 46.0

2) 2" Poplar S80deg.E 23.6

Washtenaw County Road Commission Grid Book, Date & Origin unknown

3) 12" Elm N60deg.E 94.6

4) 12" Elm N45deg.E 79.0

5) Power Pole East 51.0

Washtenaw Engineering Co., Inc., Norman N. Fahrner, PLS#17620, September 1972
Land Corner Recordation Certificate, Liber 2, Page 133
Found 1-1/2" Iron Pipe

5) Power Pole N82deg.E 51.0

6) Power Pole West 58.2

7) 10" Spruce N84deg.E 66.0

Patrick L. Benton, PLS#19826, February 1975

Survey Drawing, Found 1-1/2" Iron Pipe

5) Utility Pole East 50.78 (nail N/S)

6) Tele. Pole N80deg.W 58.24 (nail N/S)

8) 12" Pine S80deg.E 66.91 (nail N/S)

C. Wilson & Associates, Inc., Charles C. Wilson, PLS #13604, September 1978

Survey Drawing, Found 1-1/2" Iron Pipe

5) Power Pole N82deg.E 51.0

6) Power Pole West 58.2

7) 10" Spruce N84deg.E 66.0

Donald L. Bissell, PLS#18655, September 1987

Land Corner Recordation Certificate Liber 7, Page 141

5) Power Pole N82deg.E 51.0

6) Power Pole West 58.2

7) 10" Spruce N84deg.E 66.0

C. Wilson & Associates, Inc., Craig A. Eckfeld, PLS #33135, November 1988

Survey Drawing, Found 1-1/4" Iron Pipe

5) Utility Pole N82W 50.78 (nail)

6) Tele. Pole W 58.2 (nail)

7) 20" Pine N84E 66.00 (nail)

8) 20" Pine S85E 66.91 (nail)



-COPY

