SURVEY &
REMONUMENTATION

MAY - 1 1995

COMMISSION

COPY

RECORDED
WASHTENAW COUNTY, MI

JAN 10 9 46 AM '95

PEGGY H. HAINES
COUNTY CLERK/REGISTER

-COPY-

LIBER 1 PAGE 295 RM

-Copy-

Register of Deeds Stamp & File Number

LAND CORNER RECORDATION CERTIFICATE

Filing Requirement of Act 74, Mich. P.A. 1970

For corners in Washtenaw (County)

	Located In:	Corner Code ##
1. Public Land Survey	T 1S R 3E	M-10
	T ___ R ___	
	T ___ R ___	
	T ___ R ___	
2. Property Controlling	S ___ T ___ R ___	
in Section	S ___ T ___ R ___	
3. Miscellaneous	S ___ T ___ R ___	
Property in Sec.	S ___ T ___ R ___	

4. Lot No. _____ , Recorded Plat _____
5. Private Claims _____

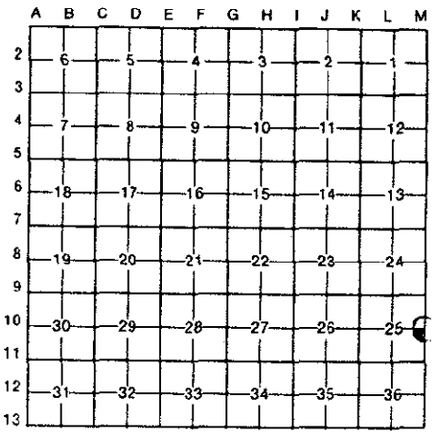

I, Charles C. Wilson, in a field survey on December 3, 19 94, do hereby certify that under requirements of P.A. 74, Michigan P.A. of 1970, the corner points mentioned in lines 1 and 2 above were in conformance with regulations and rules therefore as required in the current manual of survey instructions of the United States Department of the Interior, Bureau of Land Management or by a decree of a Court of Law and/or that the corner points mentioned in lines 3, 4 and 5 above were in conformance with the rules of the Michigan Board of Land Surveyors or by a Decree of a Court of Law; established, re-established, monumented, re-monumented, recovered, found as expressed below:

NOTE: Not more than 4 corners, all in the same town and range, may be recorded on this certificate.

A. Description of original monument and accessories and/or subsequent restoration:

United States Government, 1815 Instructions, Surveyed 1815, Bearing Trees W. Oak 16" N89deg.E 113 Links(74.58)
W. Oak 9" S43deg.E 96 Links(63.36)
Meas. (N) 40 Chains(2640)
(S) 40 Chains(2640)

Washtenaw Engineering Co., Inc., June 17, 1993
Norman N. Fahrner, PS #17620
Found Iron Pipe
12" Tamarack (Dead) N35deg.E 15.2
14" Tamarack (Dead N85deg.E 26.1
N-S Fence E'ly 11.1

B. Description of corner evidence found and/or method applied in restoring or reestablishing corner:

Could not find previous Iron Pipe referred to in survey by Washtenaw Engineering Co., Inc, 1993. Re-established point with a 1-1/4"x48" Iron Pipe with a Remonumentation Cap stamped #13604 using previous survey dimensions from M-9 S'ly and L-10 E'ly. The location of this point is fairly consistent with other observed dimensions along the township line.

C. Description of monument for corner and accessories established to perpetuate locating the position of the corner:

Corner (M-10) 1-1/4x48" Iron Pipe in Marsh with a Remonumentation Cap stamped #13604. Water approximately 2' deep. Iron exposed 3" above water surface.
N-S Fence E'ly 11'+-* 6" Cottonwood E'ly 52.48(Nail & RT N/S)
14" Tamarack (Dead) N55E 44.53(Nail & RT SE/S)
10" Cottonwood N35deg.E 54.04(Nail & RT SE/S)
8" Tamarack (Dead) N20deg.E 52.50(Nail & RT SE/S)
Wood Fence Post S30deg.E 24.24(Nail & RTNE/S)
*indicates accessory previously mentioned in Paragraph A
I find no evidence to conflict with the acceptance of this point as being the best available evidence for the location of the original corner.
This point was ratified by the Washtenaw County Peer Committee on December 5, 1994

APPROVED
DATE 12/5/94
CO. REP. KA

STATE OF MICHIGAN
CHARLES C. WILSON
NO 13604
PROFESSIONAL SURVEYOR

Signed by Chas C. Wilson Date December 5, 1994

Surveyor's Michigan License No. 13604

FORM APPROVED BY MICHIGAN STATE BOARD OF LAND SURVEYORS, JAN. 28, 1971
REVISED MAY 14, 1975
REVISED JAN., 1983