

REMONUMENTATION

RECORDED  
WASHTENAW COUNTY, MI

MAY - 1 1995

COPY

JAN 10 9 46 AM '95

LAND CORNER RECORDATION CERTIFICATE  
Filing Requirement of Act 74, Mich. P.A. 1970

For corners in  
Washtenaw  
(County)  
COMMISSION

PEGGY M. HAINES  
COUNTY CLERK/REGISTER

-COPY-

Located In:	Corner Code #
1. Public Land Survey	T 1S R 3E M-11
	T R
	T R
	T R
2. Property Controlling in Section	S T R
	S T R
3. Miscellaneous Property in Sec.	S T R
	S T R

LIBER

1 PAGE 296 RM

-Copy-

Register of Deeds Stamp & File Number

- 4. Lot No. \_\_\_\_\_, Recorded Plat \_\_\_\_\_
- 5. Private Claims \_\_\_\_\_

	A	B	C	D	E	F	G	H	I	J	K	L
2	6	5	4	3	2	1						
3												
4	7	8	9	10	11	12						
5												
6	18	17	16	15	14	13						
7												
8	19	20	21	22	23	24						
9												
10	30	29	28	27	26	25						
11												
12	31	32	33	34	35	36						
13												

I, Charles C. Wilson, in a field survey on December 3, 1994, do hereby certify that under requirements of P.A. 74, Michigan P.A. of 1970, the corner points mentioned in lines 1 and 2 above were in conformance with regulations and rules therefore as required in the current manual of survey instructions of the United States Department of the Interior, Bureau of Land Management or by a decree of a Court of Law and/or that the corner points mentioned in lines 3, 4 and 5 above were in conformance with the rules of the Michigan Board of Land Surveyors or by a Decree of a Court of Law; established, re-established, monumented, re-monumented, recovered, found as expressed below:

NOTE: Not more than 4 corners, all in the same town and range, may be recorded on this certificate.

A. Description of original monument and accessories and/or subsequent restoration:

United States Government Survey, 1815 Instructions, Surveyed 1815, Bearing Trees B. Oak 12" N35deg.E 70 Links(46.20)  
W. Oak 10" N77deg.E 71 Links(46.86)  
Meas. (N) 40 Chains(2640)  
(S) 40 Chains(2640)  
(W) 39.50 Chains(2607)

Russell Whipple, 1840's  
W. Oak 10" N77deg.E 71 Links(46.86)  
B. Oak 8" S57-1/2deg.E 44 Links(29.04)

Continued on back:


B. Description of corner evidence found and/or method applied in restoring or reestablishing corner:

Found a 1"(OD)-3/4"(ID)x34" Iron Pipe in Marsh. Water depth approximately 2'. Reset with a 1-1/4"x48" Iron Pipe with Remonumentation Cap stamped #13604 to 4" above water surface. I believe this to be the point accepted by W.J. Armstrong, in 1939

C. Description of monument for corner and accessories established to perpetuate locating the position of the corner:

Corner (M-11) 1-1/4"x48" Iron Pipe in Marsh with a Remonumentation Cap stamped #13604. Water approximately 2' deep. Exposed 4" above water surface.  
24" Cherry S'y 258.7(Nail W/S)\* Iron Pipe (A-11) T1S, R4E, N'y 28.80\*  
3" Tamarack N35deg.W 12.62(Nail & RT SW/S)\* 3" Tamarack S30deg.W 31.64(Nail & RT SE/S)\*  
4" Tamarack S10deg.W 49.38(Nail & RT SW/S) 4" Tamarack E'y 12.18(Nail & RT S/S)

\*indicates accessory previously mentioned in Paragraph A  
I find no evidence to conflict with the acceptance of this point as being a careful and faithful perpetuation of the original corner.  
This point was ratified by the Washtenaw County Peer Committee on December 5, 1994

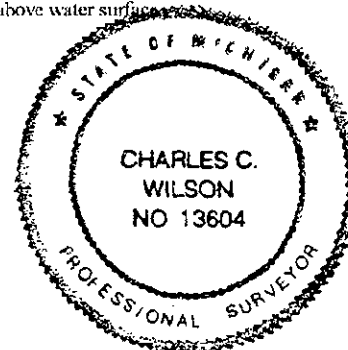

Signed by Charles C. Wilson Date December 5, 1994

Surveyor's Michigan License No. 13604

LIBER 1 PAGE 297 RM  
- copy -

Paragraph A Continued:

William J. Armstrong, PS #2444, March 31, 1939  
Found 3/4"x36" Iron Pipe protruding out of swamp water. Iron Pipe is between 2 Wood Stakes.  
Placed 3 Bricks around Iron Pipe.  
Cherry 14" S4deg.W 256.6

Atwell-Hicks, Inc., July 14, 1971  
Found 3/4" Iron Pipe  
4" Tamarack Ely 41.9  
3" Tamarack N20deg.E 12.7  
30" Willow N79deg.W 222.8  
24" Cherry W'ly 260.2

Atwell-Hicks Inc., February 29, 1972  
Robert J. Jagow, PS #6998  
Found 3/4" Iron Pipe in Tamarack Swamp Liber 1, Page 543  
Same as July 14, 1971

Atwell-Hicks, Inc., April 10, 1972  
Rober J. Jagow, PS #6998  
Found Iron Pipe  
Same as Liber 1, Page 543

Midwestern Consulting, Inc., April 6, 1977  
Allen R. Rentschler, PS #15411  
Found Iron Pipe  
Iron Pipe (A-11) T1S, R4E, N'ly 28.70

Washtenaw Engineering Co., Inc., June 17, 1993  
Norman N. Fahrner, PS #17620  
Found 3/4" Iron Pipe  
Iron Pipe (A-11) T1S, R4E, N'ly 28.50  
2" Tamarack N35deg.W 12.8  
3" Tamarack S30deg.W 31.5

APPROVED  
DATE 12/5/94  
CO. REP. KA