

REF

2690

SECTION

LAND CORNER RECORDATION CERTIFICATE

Filing Requirement of Act 74, Mich. P.A. 1970

For Corners in

Washtenaw (County)

Located In:

Corner Code #

1. Public Land Survey

T 1S R 4E
T
T
T
S
S
S

H11



5094759
Page: 1 of 2
02/07/2000 02:55P

2. Property Controlling in Section

3. Miscellaneous Property in Sec.

4. Lot No. , Recorded Plat

5. Private Claim

Register of Deeds Stamp & File Number

I, R. Timothy Tietsema, in a field survey on 8 February, 1999, do hereby certify that under requirements of P.A. 74, Michigan P.A. of 1970, the corner points mentioned in lines 1 and 2 above were in conformance with regulations and rules therefore as required in the current manual of survey instructions of the United States Department of the Interior, Bureau of Land Management or by a decree of a Court of Law and/or that the corner points mentioned in lines 3, 4 and 5 above were in conformance with the rules of the Michigan Board of Land Surveyors or by a Decree of a Court of Law; established, re-established, monumented, re-monumented, recovered, found as expressed below:

NOTE: Not more than 4 corners, all in the same town and range, may be recorded on this certificate.

A. Description of original monument and accessories and/or subsequent restoration:

Table with columns for Date, Surveyor, Description, Monument Type, and Measurements. Includes entries for J. Wampler (1825), W.J. Armstrong (11/31/1934), Norman N. Fahrner (07/08/1971), Associated Eng. & Surveyors Inc. (12/07/1972), Detroit Edison Co. (11/08/1973), and C. Wilson & Assoc. (08/13/1979).

continued on back

B. Description of corner evidence found and/or method applied in restoring or reestablishing corner:

Found 1 1/2" Iron Pipe, with brick and stones using accessories 3,4,5, and 8.

C. Description of monument for corner and accessories established to perpetuate locating the position of the corner:

Set 1/2" iron rod with Washtenaw County Remonumentation Cap in existing 1 1/2" iron pipe 0.4 feet below ground surface of Michigan State Plane Coordinates values of North 312,108.73 and East 13,236,112.54. Accessories perpetuated or established as follows:


- 3) 55" White Oak S30E 6.60' Set P.K. nail with Remonumentation washer West side
4) 50" White Oak S10E 79.39' Set P.K. nail with Remonumentation washer West side
5) 40" White Oak S08E 171.97' Set P.K. nail with Remonumentation washer West side
8) Power Pole NS0W 96.32' Set P.K. nail with Remonumentation washer South side
9) NW cor. Pole Barn S83E 136.70'

I find that this corner represents the best available evidence for the position of the original corner. This corner was ratified by the Washtenaw County Peer Committee on November 22, 1999.

Signed by [Signature]

Date

Surveyor's Michigan License No. 20712

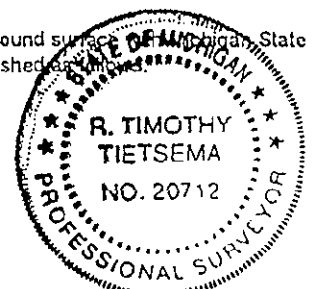

NOV 23 1999

Copy



Peggy M. Haines - Washtenaw Co. CORREM L-3 P-37

11/19/1979	C. Wilson & Assoc. Job No. 79231 CCW #13604	Survey	Found 1 1/2 iron pipe	3) 48" White Oak 4) 48" White Oak 5) 36" White Oak 6) Power Pole 7) Power Pole	S20E 7.6' S01E 79.0' South 171.1' N45E 77.9' S40E 78.2'
11/19/1979	C. Wilson & Assoc. Job No. 79231 CCW #13604	Survey	Found 1 1/2 iron pipe	3) 48" White Oak 4) 48" White Oak 5) 36" White Oak 6) Power Pole 7) Power Pole	S20E 7.6' S01E 79.0' South 171.1' N45E 77.9' S40E 78.2'
11/16/1982	C. Wilson & Assoc. Job No. 82037 CCW #13604	Survey	Found 1 1/2 iron pipe	3) 48" White Oak 4) 48" White Oak 5) 36" White Oak 6) Power Pole 7) Power Pole	S20E 7.6' S01E 79.0' South 171.1' N45E 77.9' S40E 78.2'
08/31/1984	C. Wilson & Assoc. "Mach II" L24 P.38	Plat	Not Stated	None Given	
9/14/87	Detroit Edison Co. Job #8702051 GDS #14092	Survey	Not Stated	None Given	
07/21/1988	C. Wilson & Assoc. Job No. 88224-A CAE #33135	Survey	Not Stated	3) 60" Oak 4) 40" Oak 6) Utility Pole 8) Utility Pole	S20E 7.67' to Nail South 79.12' to Nail N70E 77.88' to Nail N38W 96.55' to Nail
11/16/1982	C. Wilson & Assoc. Job No. 88268 CCW #13604	Survey	Found 1 1/2 iron pipe	3) 48" White Oak 4) 48" White Oak 5) 36" White Oak 6) Power Pole 7) Power Pole	S20E 7.6' S01E 79.0' South 171.1' N45E 77.9' S40E 78.2'
07/21/1988	C. Wilson & Assoc. Job No. 92061 CCW #13604	Survey	Not Stated	3) 60" Oak 4) 40" Oak 6) Utility Pole 8) Utility Pole	S20E 7.67' to Nail South 79.12' to Nail N70E 77.88' to Nail N38W 96.55' to Nail

REF

2000

SECTION

