

**SURVEY &  
REMONUMENTATION**

MAY - 1 1995

**LAND CORNER RECORDATION CERTIFICATE**  
Filing Requirement of Act 74, Mich. P.A. 1970

For corners in **COMMISSION**

Washtenaw (County) Located In: Corner Code #


1. Public Land Survey T 1S R 4E K-10  
T R  
T R  
T R

2. Property Controlling S T R  
in Section S T R  
3. Miscellaneous S T R  
Property in Sec. S T R

4. Lot No. \_\_\_\_\_, Recorded Plat \_\_\_\_\_

5. Private Claims \_\_\_\_\_

RECORDED  
WASHTENAW COUNTY, MI  
DEC 1 11 28 AM '94  
PEGGY M. HAINES  
COUNTY CLERK/REGISTRAR  
- Copy -  
LIBER 1 PAGE 134 RM  
Register of Deeds Stamp & File number

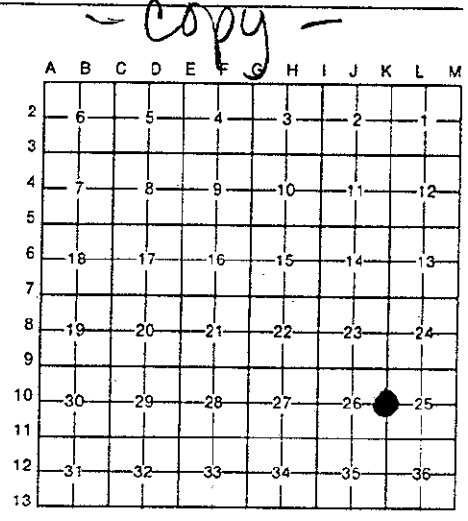

I, R. Timothy Tietsema, in a field survey on April 20, 19 94, do hereby certify that under requirements of P.A. 74, Michigan P.A. of 1970, the corner points mentioned in lines 1 and 2 above were in conformance with regulations and rules therefore as required in the current manual of survey instructions of the United States Department of the Interior, Bureau of Land Management or by a decree of a Court of Law and/or that the corner points mentioned in lines 3, 4 and 5 above were in conformance with the rules of the Michigan Board of Land Surveyors or by a Decree of a Court of Law; established, re-established, monumented, re-monumented, recovered, found as expressed below:

**NOTE: Not more than 4 corners, all in the same town and range, may be recorded on this certificate.**

**A. Description of original monument and accessories and/or subsequent restoration:**

DATE	SURVEYOR	LS#	LCRC	SURVEY	MONUMENT DESC.	WITNESSES
1819	GLO (Wampler)			Fld. Notes	Set Original Corner Set 1/2 mile post.	1) 4" W. Oak S75W 143 links(94.38") 2) 36" W. Oak S05E 153 links(100.98")
June 1940	W.J. Armstrong	W.C.R.C.		Resurvey	Fnd old wood stake, reset with 1 1/2" IP, stones and brick.	3) 3" Dbl Hickory N37E 32.0' 4) 18" Hickory N88E 85.4' 5) 10" Hickory S35E 48.5' 6) 28" W. Oak N67E 53.5'

CONTINUED ON BACK

**B. Description of corner evidence found and/or method applied in restoring or reestablishing corner:**

In April of 1994, LSC found a 1 1/2" iron pipe using these witnesses:

Fnd. 1 1/2" IP 2' S. of N. edge Fleming Rd., 0.2' below surf. in old fenceline to S. (small pieces of brick fnd. by pipe).	5) 24" Hickory	S35E	48.5'
	6) 40" W. Oak	N67E	53.5'
	7) 22" Dbl. Oak	NORTH	7.55'
	8) Iron Pipe	SOUTH	33.08'
	9) Conc. Mon.	SOUTH	64.75'

**C. Description of monument for corner and accessories established to perpetuate locating the position of the corner:**

April 20 1994	R. T. Tietsema	20712	Remon.	Fnd. 1 1/2" Iron Pipe Added a Wash. Co. Remon. Cap.	5) 24" Hickory S35E 48.58' to nail & R.T. 6) 40" Oak N65W 53.52' to nail & R.T. 7) 15" Oak (6 trunks) N55E 7.62' to nail & R.T. 8) Fnd 3/4" I.P. SOUTH 33.15' 9) Conc. Mon. SOUTH 64.80' 12) 14" Dbl. Oak N30W 19.29' to nail & R.T.
---------------	----------------	-------	--------	-----------------------------------------------------------	---

It is our opinion that this corner represents the original corner and is accepted as a careful and faithful perpetuation of the position of the original corner.

Signed by R. Timothy Tietsema Date May 6 1994

Surveyor's Michigan License No. 20712

CONTINUED FROM A. ON FRONT:

DATE	SURVEYOR	LS#	LCRC	SURVEY	MONUMENT DESC.	WITNESSES
6/10/1972	N. N. Fahrner	17620	L2P145		Fnd. 1 1/2" Iron Pipe	3) 6" Dbl Hickory N37E 32.0' 4) 26" Hickory N88E 85.4' 5) 22" Hickory S35E 48.5' 6) 30" W. Oak N67E 53.5'
1/8/1975	John L. Snyder	13352	L4P128		Fnd. 1 1/2" Iron Pipe	4) 30" Hickory N88E 85.4' 5) 24" Hickory S35E 49.5' 6) 40" Oak N70W 53.5' 7) 12" Tw. Oak N45E 7.7' MSPC System 315, 083.99(N) & 2, 111, 510.87(E)
3/15/1977	Howard W. Taft JOB NO: 31706	12032	L4P195	Boundary	Fnd. 1 1/2" Iron Pipe	4) 30" Hickory N88E 85.4' 5) 24" Hickory S35E 49.4' 6) 40" Oak N70W 53.5' 7) 12" Twin Oak N45E 7.7'
3/4/1978 fence line S'y.	Paul V. Schwimmer CLIENT: Jack Henderson	24618		Boundary	1 1/2" Iron Pipe with bricks.	4) 30" Hickory N88E 85.4' On range 5) 24" Hickory S35E 49.4' 6) 40" Oak N70W 53.5' 7) 12" Twin Oak N45E 7.7'
11/5/1980	Robert G. Macomber CLIENT: Ruth Doletzky	27453		Boundary	1 1/2" Iron Pipe	4) 30" Hickory N88E 85.4' 5) 24" Hickory S35E 49.4' 6) 40" Oak N70W 53.5' 7) 12" Twin Oak N45E 7.7' 8) Iron Pipe SOUTH 33.08' 9) Conc. Mon. SOUTH 64.75'
1/16/1989	R. T. Tietsema	20712		Boundary	Fnd. 1 1/2" Iron Pipe	7) 22" Dbl. Oak NORTH 7.55' 10) 22" Maple EAST 47.9' 11) 24" Dbl. Oak WEST 18.3'
August 1990	R. T. Tietsema JOB NO: 10390 JOB NO: 16290	20712		Boundary	Fnd. 1 1/2" Iron Pipe	4) 30" Hickory N88E 85.4' 5) 24" Hickory S35E 48.5' 6) 40" W. Oak N67E 53.5'

APPROVED  
 DATE 5/13/94  
 CO. REP. K