

RFA

2000

SECTION

LAND CORNER RECORDATION CERTIFICATE

Filing Requirement of Act 74, Mich. P.A. 1970

For Corners in

Washtenaw Located In: _____ Corner Code # _____
 (County)

1. Public Land Survey T 1S R 4E L9
 T _____ R _____
 T _____ R _____
 T _____ R _____

2. Property Controlling S _____ R _____
 in Section S _____ T _____ R _____
 3. Miscellaneous S _____ T _____ R _____
 Property in Sec. S _____ T _____ R _____

4. Lot No. _____, Recorded Plat _____
 5. Private Claim _____



5094762
 Page: 1 of 1
 02/07/2000 02:55P
 L-3 P-40

Register of Deeds Stamp & File Number

A	B	C	D	E	F	G	H	I	J	K	L	M
2	6	5	4	3	2	1						
3												
4	7	8	9	10	11	12						
5												
6	10	17	16	15	14	13						
7												
8	19	20	21	22	23	24						
9												
10	30	29	28	27	26	25						
11												
12	31	32	33	34	35	36						
13												

I, R. Timothy Tietsema, in a field survey on 20 September, 1999, do hereby certify that under requirements of P.A. 74, Michigan P.A. of 1970, the corner points mentioned in lines 1 and 2 above were in conformance with regulations and rules therefore as required in the current manual of survey instructions of the United States Department of the Interior, Bureau of Land Management or by a decree of a Court of Law and/or that the corner points mentioned in lines 3, 4 and 5 above were in conformance with the rules of the Michigan Board of Land Surveyors or by a Decree of a Court of Law; established, re-established, monumented, re-monumented, recovered, found as expressed below:

NOTE: Not more than 4 corners, all in the same town and range, may be recorded on this certificate.

A. Description of original monument and accessories and/or subsequent restoration:

1819	GLO(Wampler)	Fld. Notes	Set Original Corner Set 1/4 Post at avg. dist. 39.88 chains (2632.08').	1) 36" W. Oak 2) 6" Ash	N30W 4 links (2.64') S40E 41 links (27.06')
04/1927	H.H. Atwell Job #201-28	Survey	Not stated	3) 3' south of E-W fence	
No Date	H.H. Atwell	W.C.R.C. Compiled surveys Sketch		4) 10" Hickory 5) 12" B. Oak 6) 12" Maple	N53W 12.5' N05E 14.9' S87E 37.2'

B. Description of corner evidence found and/or method applied in restoring or reestablishing corner:


Found old 3/4" iron pipe on South side of old E-W stone fence row. Measured distance to NE corner Section 25 is 2852.91 feet, recorded distance from survey by H.H. Atwell (1927 Job #201-28) was 2856.41 feet. Measured distance to NW corner Section 25 is 2337.42 feet, recorded distance from survey by H.H. Atwell (1927 Job #201-28) was 2337.63 feet. Interior angle at the N1/4 corner of section 25 between the NE and NW corners of Section 25 measured 178 deg. 30 min. 43 sec., recorded angle by H.H. Atwell (1927 Job #201-28) was 178 deg. 17 min. 30sec.

C. Description of monument for corner and accessories established to perpetuate locating the position of the corner:

Reset with 3/4" iron pipe with Washtenaw County Remonumentation Cap on south side of E-W stone fence row, with Michigan State Plane Coordinate values of North 317,497.31 and East 13,245,046.38. Accessories established as follows:

7) 20" Oak	N15E	31.48'	Set P.K. nail with Washtenaw County Remonumentation washer on east side.
8) 30" Ash	N75E	30.29'	Set P.K. nail with Washtenaw County Remonumentation washer on south side.
9) 24" Oak	S35E	31.72'	Set P.K. nail with Washtenaw County Remonumentation washer on north side.
10) 20" Oak	N75W	24.54'	Set P.K. nail with Washtenaw County Remonumentation washer on northeast side.

I find that this corner represents the best available evidence for the position of the original corner. This corner ratified by the Washtenaw County Peer Committee on November 22, 1999.

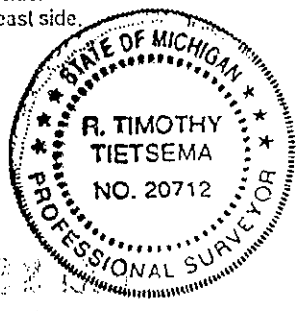

Signed by R. Timothy Tietsema
 Surveyor's Michigan License No. 20712

Date NOV 22 1999