

SECTION

LAND CORNER RECORDATION CERTIFICATE

Filing Requirement of Act 74, Mich. P.A. 1970

For Corners in

Washtenaw  
(County)

Located In:

Corner Code #

1. Public Land Survey

T 1S R 4E

M10

*Cover*

2. Property Controlling  
in Section

S T R  
S T R

3. Miscellaneous  
Property in Sec.

S T R  
S T R



5094763  
Page: 1 of 1  
02/07/2000 02:55P

Peggy M. Haines - Washtenaw Co. CORREM L-3 P-41

Register of Deeds Stamp & File Number

4. Lot No. \_\_\_\_\_, Recorded Plat \_\_\_\_\_  
5. Private Claim \_\_\_\_\_

A	B	C	D	E	F	G	H	I	J	K	L	M
2	6	5	4	3	2	1						
3												
4	7	8	9	10	11	12						
5												
6	13	14	15	16	17	18						
7												
8	19	20	21	22	23	24						
9												
10	25	26	27	28	29	30						
11												
12	31	32	33	34	35	36						
13												

R. Timothy Tietsema, in a field survey on 30 August, 1999, hereby certify that under requirements of P.A. 74, Michigan P.A. of 1970, the corner points mentioned in lines 1 and 2 above were in conformance with regulations and rules therefore as required in the current manual of survey instructions of the United States Department of the Interior, Bureau of Land Management or by a decree of a Court of Law and/or that the corner points mentioned in lines 3, 4 and 5 above were in conformance with the rules of the Michigan Board of Land Surveyors or by a Decree of a Court of Law; established, re-established, monumented, re-monumented, recovered, found as expressed below:

NOTE: Not more than 4 corners, all in the same town and range, may be recorded on this certificate.

A. Description of original monument and accessories and/or subsequent restoration:

1819	GLO(Wampler)	Fld. Notes	Set Original Corner	1) 10" W. Oak	S37W	22 links (14.52')
			Set 1/4 Section Post	2) 12" B. Oak	N25E	30 links (52.80')
			Set 1/4 Section Post			

B. Description of corner evidence found and/or method applied in restoring or reestablishing corner:

Found old 3/4" iron pipe on South side of remnants of old wood fence corner post. Remnants of old fence run southerly, westerly, and easterly.


C. Description of monument for corner and accessories established to perpetuate locating the position of the corner:

Set Washtenaw County Remonumentation Cap on existing 1/2" iron pipe, with Michigan State Plane Coordinate values of North 314,341.49 and East 13,248,964.07. Accessories established as follows:

3) 45" Twin Ash	N07E	10.92'	Set P.K. Nail with Remonumentation washer on southeast side.
4) 24" Twin Maple	S55E	60.13'	Set P.K. Nail with Remonumentation washer on south side.
5) 18" Oak	S68W	28.71'	Set P.K. Nail with Remonumentation washer on north side.
6) 12" Ash	N32W	46.17'	Set P.K. Nail with Remonumentation washer on south side.

APPROVED  
DATE 11/22/99  
CO. REP. *KA*

I find that this corner represents the best available evidence for the position of the original corner. This corner ratified by the Washtenaw County Peer Committee on November 22, 1999.

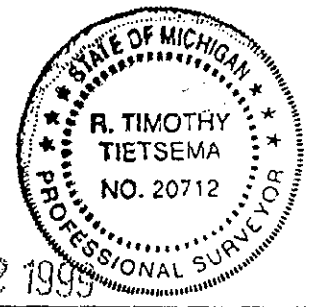

Signed by *R. Timothy Tietsema*

Date NOV 22 1999

Surveyor's Michigan License No. 20712