

MAR 09 1998

RECORDED
WASHTENAW COUNTY, MI

SECTION

LAND CORNER RECORDATION CERTIFICATE JAN 22 8 31 AM '98
Filing Requirement of Act 74, Mich. P.A. 1970

For corners in

WASHTENAW
(County)

Located In:

Corner Code #

Webster Twp.
G - 10

- | | | | |
|------------------------------------|--------------|--------------|---------|
| 1. Public Land Survey | T <u>1</u> S | R <u>5</u> E | _____ |
| | T _____ | R _____ | _____ |
| | T _____ | R _____ | _____ |
| | T _____ | R _____ | _____ |
| 2. Property Controlling in Section | S _____ | T _____ | R _____ |
| | S _____ | T _____ | R _____ |
| 3. Miscellaneous Property in Sec. | S _____ | T _____ | R _____ |
| | S _____ | T _____ | R _____ |


PEGGY M. HAINES
COUNTY CLERK/REGISTER

- COPY -
- COPY -

Liber 00002 Page 0027 RM

Register of Deeds Stamp & File Number

4. Lot No. _____, Recorded Plat _____
5. Private Claims _____

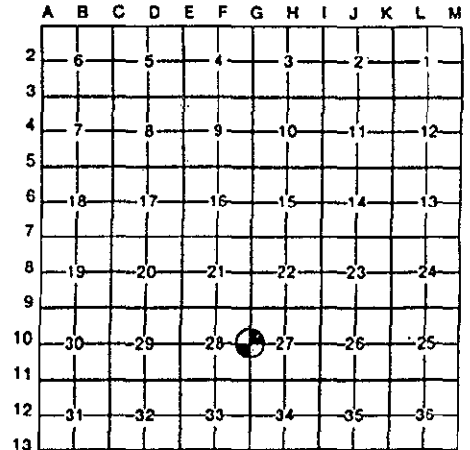

I, J. JOHN JEKABSON, in a field survey on 14 October, 1997, do hereby certify that under requirements of P.A. 74, Michigan P.A. of 1970, the corner points mentioned in lines 1 and 2 above were in conformance with regulations and rules therefore as required in the current manual of survey instructions of the United States Department of the Interior, Bureau of Land Management or by a decree of a Court of Law and/or that the corner points mentioned in lines 3, 4 and 5 above were in conformance with the rules of the Michigan Board of Land Surveyors or by a Decree of a Court of Law; established, re-established, monumented, re-monumented, recovered, found as expressed below:

NOTE: Not more than 4 corners, all in the same town and range, may be recorded on this certificate.

A. Description of original monument and accessories and/or subsequent restoration:

1819	G.L.O. - T. WAMPLER	SET POST	White Oak, 28" Red Oak, 38"	N 57° W 25Lks N 46° E 58Lks	
1934, 21 August	WASHTENAW CO. ROAD COMMISSION W.J. ARMSTRONG #2444	Found stones and fragments of brick but could not identify a stake. Reset with 1 1/2"x36" Iron Pipe, stones and bricks.	16" Bl. Walnut 20" Bl. Walnut Group of 4 W.O's 8" on one stump 14" Hickory 14" Butternut 2 R. of W. Pipes	N 32 1/2° W- 59.2 N 26° W 71.5 N 72° E 25.0 S 15° E 74.7 S 39° W 41.0	1 2 3 4 5 6

SEE BACK OF THIS SHEET (NEXT PAGE)
FOR CONTINUATION OF SECTION "A"

B. Description of corner evidence found and/or method applied in restoring or reestablishing corner:

FOUND 1 1/4" IRON PIPE 8" BELOW GRAVEL ROAD SURFACE.
ALSO FOUND BRICKS AND STONES AROUND IT. ARMSTRONG'S WITNESSES MATCH TO THIS IRON.
SET 1"X12" IRON PIPE WITH REMON CAP IN THE 1 1/4" IRON PIPE
USING 5 WITNESSES FROM SECTION "A"



C. Description of monument for corner and accessories established to perpetuate locating the position of the corner:

SET 1"X12" IRON PIPE WITH REMON CAP IN 1 1/4" IRON PIPE	PK & RT in NE sd 24" Black Walnut	N 33° W	59.20	1°
	PK & RT in NW sd 24" Quad White Oak	N 72° E	25.00	3°
	Spike in N sd 18" White Oak	N 80° E	16.85	87°
	PK & RT in SW sd Twin 24" Red Oak	S 35° E	49.78	9°
	Center 14" Dead Hickory	S 15° E	74.7	4°
	PK & RT in SE sd Twin 24" Oak	S 35° W	62.82	10

APPROVED
DATE 11/10/97
CO. REP. [Signature]

Legend:
PK & RT = PK Nail & Washtenaw Co. Remon. Tag
* Indicates Previously Used

I conclude that after careful study of the record documentation and field observations, that this corner is a careful and faithful perpetuation of the position of the original corner.

Signed by [Signature] Date 4 December, 1997
Surveyor's Michigan License No. 19836

History compiled by: I. John Jekabson P.S. # 19836
Roskelly, Jekabson & Assoc. P.C.

CONTINUATION OF SECTION "A"
1997 WASHTENAW COUNTY REMONUMENTATION PROGRAM
WEBSTER TOWNSHIP TOWN 1 SOUTH, RANGE 5 EAST
G-10: (1/4 CORNER COMMON TO SECTIONS 27 & 28)

DATE	COMPANY SURVEYOR & P.S. #	JOB #	P.A. 74 L.C.R.C.	LOCATION OF SURVEY	MONUMENT DESCRIPTION	WITNESSES	BEARING & DISTANCE	ID #	COMMENT
1964 21 December	ATWELL-HICKS, INC.	23014			Found Iron Pipe	No Witnesses			
1973 18 April	WASHTENAW ENG. CO. NORMAN N. FAHRNER #17620	9888		N.E. 1/4 Sec. 28	Found 1 1/2" Iron Pipe	22" B. Walnut Group of 4 Hick. on one stump 22" Hickory 18" Oak 14" Hickory	N 32 1/2° W 59.2 N 72° E 25.0 S 15° E 74.7 S 25° W 62.5 N 72° E 17.0	1* 3*7 4* 7 8	
1983 18 April	WASHTENAW ENG. CO JOHN F. OLIVER #19840		Liber 2, Page 639		Found 1 1/2" Iron Pipe	Same as 18 April, 1973			
1980 26 March	WASHTENAW ENG. CO T.L. SUTHERLAND # 24620	17423		N.W. 1/4 Sec. 27	Found 1 1/2" Iron Pipe	Same as 18 April, 1973			
1980 22 April	WASHTENAW ENG. CO T.L. SUTHERLAND # 24620	17485		N.W. 1/4 Sec. 27	Found 1 1/2" Iron Pipe	Same as 18 April, 1973			
1991 March	LAND SURVEYING CONSULTANTS R. TIMOTHY TIETSEMA # 20712	02691- 1SSE28		S.W. 1/4 Sec. 28	Fnd. 1 1/2" I.P.	24" Oak 24" Twin Oak 30" Oak 30" Walnut	N 55° E 16.95 S 35° E 49.78 S 40° W 61.42 N 40° W 59.40	8*7 9 7* 1*	
1996 5 April	ATWELL-HICKS, INC. TODD D. SHELLY # 41111	42346		S.W. 1/4 Sec. 27	Found 1" Iron Pipe	Nail E face 24" Oak Nail N face 18" Oak Nail W face Twin 20" Oak Nail E face Twin 24" Hickory	N 30° W 59.38 N 80° E 16.85 S 08° E 49.70 S 35° W 62.82	1* 8*7 9* 10	

Legend:
* Indicates Previously Used