

SURVEY & REMONUMENTATION

MAR 09 1998

RECORDED
WASHTENAW COUNTY, MI

LAND CORNER RECORDATION CERTIFICATE
Filing Requirement of Act 74, Mich. P.A. 1970

JAN 22 8 31 AM '98

For corners in **SECTION**

WASHTENAW
(County)

Located In: Corner Code #

- | | | |
|------------------------------------|---------------------------|---------------|
| 1. Public Land Survey | T <u>1 S</u> R <u>5 E</u> | <u>H - 11</u> |
| | T _____ R _____ | _____ |
| | T _____ R _____ | _____ |
| | T _____ R _____ | _____ |
| 2. Property Controlling in Section | S _____ T _____ R _____ | _____ |
| | S _____ T _____ R _____ | _____ |
| 3. Miscellaneous Property in Sec. | S _____ T _____ R _____ | _____ |
| | S _____ T _____ R _____ | _____ |


Webster Twp.

PEGGY M. HAINES
COUNTY CLERK/REGISTER

- COPY -
- COPY -

Liber **00002** Page **0037** RM
Register of Deeds Stamp & File Number

4. Lot No. _____, Recorded Plat _____
5. Private Claims _____

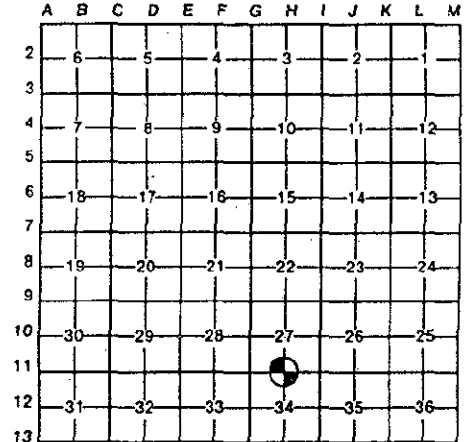

I, I. JOHN JEKABSON, in a field survey on 22 October, 1997, do hereby certify that under requirements of P.A. 74, Michigan P.A. of 1970, the corner points mentioned in lines 1 and 2 above were in conformance with regulations and rules therefore as required in the current manual of survey instructions of the United States Department of the Interior, Bureau of Land Management or by a decree of a Court of Law and/or that the corner points mentioned in lines 3, 4 and 5 above were in conformance with the rules of the Michigan Board of Land Surveyors or by a Decree of a Court of Law; established, re-established, monumented, re-monumented, recovered, found as expressed below:

NOTE: Not more than 4 corners, all in the same town and range, may be recorded on this certificate.

A. Description of original monument and accessories and/or subsequent restoration:

- | | | |
|--|--|--|
| 1819 G.L.O. - T. WAMPLER SET POST | Inn?, 8" Ash, 9" | S 19° W 4Lks
N 21° W 30Lks |
| 1954, ATWELL-HICKS, INC. Compiled Data Map | 16" B. Oak
12" Hickory
10" Elm
16" Hickory
On FL S. & 2.0 ft. N of FL E. | S 80° W 39.0
North 11.3
N 85° E 47.4
South 41.0
1
2
3
4 |

SEE BACK OF THIS SHEET (NEXT PAGE)
FOR CONTINUATION OF SECTION "A"

B. Description of corner evidence found and/or method applied in restoring or reestablishing corner:

FOUND 3/4" X 36" IRON PIPE, 8" ABOVE GROUND.
REMOVED & RECEIVED NO OTHER READING.

USING 7 WITNESSES FROM SECTION "A"



C. Description of monument for corner and accessories established to perpetuate locating the position of the corner:

- | | | | | |
|---|--|---------|-------|-----|
| RESET A 1" X 24" IRON PIPE WITH REMON. CAP. | PK & RT in SW sd 12" Shag. Hickory | N 45° W | 30.00 | 7* |
| | Center of 12" Shagbark Hickory | N 30° W | 14.7 | 9* |
| | Spike in E sd 8" Shagbark Hickory | N 20° W | 9.62 | 10* |
| | PK & RT in E sd 18" Shag. Hickory | North | 11.30 | 2* |
| | Spike in 6" Elm | S 30° E | 4.35 | 8* |
| | PK & RT in NE sd Tw. 12" Shag. Hickory | S 25° E | 19.56 | 6* |
| | PK & RT in W sd 24" Shag Hickory | South | 41.00 | 4* |

APPROVED
DATE 11/10/97
CO. REP. [Signature]

Legend:
PK & RT = PK Nail & Washtenaw Co. Remon. Tag
* Indicates Previously Used

I conclude that after careful study of the record documentation and field observations, that this corner is accepted as the best available evidence of the position of the original corner.

Signed by [Signature] Date 4 December, 1997
Surveyor's Michigan License No. 19836

- Copy -

Liber 000002 Page 0038 RM

CONTINUATION OF SECTION 'A'

1997 WASHTENAW COUNTY REMONUMENTATION PROGRAM
WEBSTER TOWNSHIP TOWN 1 SOUTH, RANGE 5 EAST
H-9 (1/4 CORNER COMMON TO SECTIONS 22 & 27)

History compiled by: I. John Jekabson P.S. # 19836
Rostkelly, Jekabson & Assoc. P.C.

DATE	COMPANY SURVEYOR & P.S. #	JOB #	P.A. 74 L.C.R.C.	LOCATION OF SURVEY	MONUMENT DESCRIPTION	WITNESSES	BEARING & DISTANCE	ID #	COMMENT
1968 20 June	ATWELL-HICKS, INC.	25425		S.W. 1/4 Sec. 22	Not Noted	None			
1970	ATWELL-HICKS, INC.	26776		N.W. 1/4 Sec. 27	Not Noted	None			
28 September 1971	ATWELL-HICKS, INC.	27297		S.E. 1/4 Sec. 22	Found Iron Pipe	40" White Oak 18" Hickory 24" Black Walnut NE Corner of Townhall NW Corner of Townhall	N 65° E 50.0 S 43° E 52.0 S 17° E 28.8 S 7.5° E 74.1	2* 3* 4* 5*	
22 October	JOHN L. SNYDER # 13352					24" Hickory 36" Hickory	S 11° W 73.9 S 14° W 45.8 N 78° W 145.4	6* 7* 8*	
1972	ATWELL-HICKS, INC.	27620		S.E. 1/4 Sec. 22	Found Iron Pipe	Same as 22 October, 1971			
12 May 1979	JOHN L. SNYDER # 13352			N.E. 1/4 Sec. 27	Found 1/2" Iron Pipe	28" Oak 48" Oak	N 30° E 48.0 N 60° E 50.2	9 2*	
8 May	ATWELL-HICKS, INC.	33005				18" Hickory 22" Hickory	S 45° E 52.0 S 05° W 46.0	3* 7*	
1979	PAUL V. SCHWINNER #24618				Found 1/2" Iron Pipe	Same as 8 May, 1979			
15 May 1987	ATWELL-HICKS, INC.		Liber 5, Page 189						
22 May	JOHN L. SNYDER # 13352			S.E. 1/4 Sec. 22	Found 1/2" Iron Pipe	42" Oak 26" B. Walnut NE Cor. of Town Hall NW Cor. of Town Hall	N 65° E 50.0 S 17° E 28.8 S 7 1/2° E 74.1 S 11° E 73.9	2* 4* 5* 6*	
1987	ROBERT G. MACOMBER # 27453	File # 502-142							
1991 August	LAND SURVEYING CONSULTANTS R. TIMOTHY TIETSEMA # 20712	07091- 1S5E22		S.E. 1/4 Sec. 22	Find. 1" I.P.	42" Oak 18" Hickory NE Cor Town Hall NW Cor Town Hall	N 67° E 49.14 S 40° E 51.31 S 05° E 73.96 S 15° W 73.91	2* 3* 5* 6*	
1992 May	LAND SURVEYING CONSULTANTS R. TIMOTHY TIETSEMA # 20712	05792- 1S5E22		S.E. 1/4 Sec. 22	Find. 1" I.P.	Same as August, 1991			
1992 30 June	PROGRESSIVE, RICHARD F. FRANK # 14093	9206-26		S.E. 1/4 Sec. 22	Found 3/4" Pipe	Spike in N side of 40" Oak Spike in N side of 15" Hickory Spike in E side of 24" Oak Spike in E side of 18" Hickory	N 70° E 49.15 S 45° E 51.29 S 30° W 93.68 N 15° W 82.06	2* 3* 10 11	

Legend:
* Indicates Previously Used