

**SURVEY & REMONUMENTATION**

MAR 09 1998

RECORDED  
WASHTENAW COUNTY, MI

**SECTION**

**LAND CORNER RECORDATION CERTIFICATE**

Filing Requirement of Act 74, Mich. P.A. 1970 JAN 22 8 31 AM '98

For corners in

<u>WASHTENAW</u> <small>(County)</small>		Located In:	Corner Code #
1. Public Land Survey	T <u>1 S</u> R <u>5 E</u>	Webster Twp.	<u>H-13</u>
	T _____ R _____		
	T _____ R _____		
	T _____ R _____		
2. Property Controlling in Section	S _____ T _____ R _____		
	S _____ T _____ R _____		
3. Miscellaneous Property in Sec.	S _____ T _____ R _____		
	S _____ T _____ R _____		
4. Lot No. _____, Recorded Plat _____			
5. Private Claims _____			

PEGGY W. HAINES  
COUNTY CLERK/REGISTER

- COPY -

- COPY -

Liber 00002 Page 0039 RM

Register of Deeds Stamp & File Number

I, L. JOHN JEKABSON, in a field survey on 22 October, 1997, do hereby certify that under requirements of P.A. 74, Michigan P.A. of 1970, the corner points mentioned in lines 1 and 2 above were in conformance with regulations and rules therefore as required in the current manual of survey instructions of the United States Department of the Interior, Bureau of Land Management or by a decree of a Court of Law and/or that the corner points mentioned in lines 3, 4 and 5 above were in conformance with the rules of the Michigan Board of Land Surveyors or by a Decree of a Court of Law; established, re-established, monumented, re-monumented, recovered, found as expressed below:

**NOTE: Not more than 4 corners, all in the same town and range, may be recorded on this certificate.**

	A	B	C	D	E	F	G	H	I	J	K	L	M
2	6	5	4	3	2	1							
3													
4	7	8	9	10	11	12							
5													
6	16	17	16	15	14	13							
7													
8	19	20	21	22	23	24							
9													
10	30	29	28	27	26	25							
11													
12	31	32	33	34	35	36							
13													

**A. Description of original monument and accessories and/or subsequent restoration:**

1819	G.L.O. - T. WAMPLER	SET POST	Hickory, 12"	S 42° W	31Lks.	
			Hickory, 8"	N 10° E	42Lks.	
1973, 13 March, ATWELL-HICKS, INC.	Set 3/4" Iron Pipe		14" Shag Hickory	S 85° E	6.1	1
JOHN L. SNYDER # 13352	1.5 S. to Fc. Line E.		3" Steel Fence Post	S 87° W	4.3	2
	& 4.1 W. to Fc. Line N.		10" Walnut	Ely	36.8	3

SEE BACK OF THIS SHEET (NEXT PAGE)  
FOR CONTINUATION OF SECTION "A"

**B. Description of corner evidence found and/or method applied in restoring or reestablishing corner:**

FOUND 3/4" X 20" IRON PIPE 4" ABOVE GROUND.  
REMOVED & RECEIVED NO OTHER READING.

USING 4 WITNESSES FROM SECTION "A"



**C. Description of monument for corner and accessories established to perpetuate locating the position of the corner:**

RESET A 1" X 24" IRON PIPE WITH REMON. CAP.	PK & RT in E sd 10" Walnut	N 12° W	45.44	4"
	PK & RT in N sd 12" Bl. Walnut	S 87° E	36.80	3"
	PK & RT in N sd 20" Shag. Hickory	S 85° E	6.10	1"
	NE Face of 3" Dia. Steel Post	S 87° W	4.30	2"


APPROVED  
DATE 11/10/97  
CO. REP. [Signature]

Legend:  
PK & RT = PK Nail & Washtenaw Co. Remon. Tag  
\* Indicates Previously Used

I conclude that after careful study of the record documentation and field observations, that this corner is accepted as the best available evidence of the position of the original corner.

Signed by [Signature] Date 4 December, 1997  
Surveyor's Michigan License No. 19836

CONTINUATION OF SECTION "A"

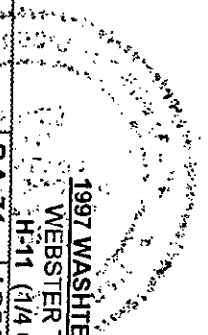

1997 WASHTEENAW COUNTY REMONUMENTATION PROGRAM  
 WEBSTER TOWNSHIP TOWN 1 SOUTH, RANGE 5 EAST  
 H-11 (3/4 CORNER COMMON TO SECTIONS 27 & 34)

History compiled by:

L. John Jakabson P.S. # 19836  
 Roskelly, Jakabson & Assoc. P.C.

Liber 000002 Page 0040 RM

copy

DATE	COMPANY SURVEYOR & P.S. #	JOB #	P.A. 14 L.C.R.C.	LOCATION OF SURVEY	MONUMENT DESCRIPTION	WITNESSES	BEARING & DISTANCE	ID #	COMMENT
1973 13 March	ATWELL-HICKS, INC. JOHN L. SNYDER # 13952	28237		N.W. 1/4 Sec. 34	Found 3/2" Iron Pipe	14" Hickory 18" Hickory 12" Twin Hickory On Fl. S. & 2.0 ft. N of Fl. E.	N 5° E 11.0 South 41.0 S 25° E 20.3	2* 4* 6	
1980 21 August	WASHTEENAW ENG. CO. NORMAN N. FAHRNER #17620		Liber 6, Page 110		Found 3/2" Iron Pipe	9" Shag Hickory Nail 6" Elm Nail 10" Hickory Nail 16" Hickory Nail 8" Hickory	N 45° W 30.0 S 30° E 4.55 N 50° W 14.72 Northerly 11.37 N 30° W 9.62	7 8 9 2*	
1960 25 August	WASHTEENAW ENG. CO. NORMAN N. FAHRNER #17620	17668		S.E. 1/4 Sec. 27	Found 3/2" Iron Pipe	Same as 21 August, 1980			
1988 1 March	WASHTEENAW ENG. CO. T.L. SUTHERLAND # 24620	21795		E. 1/4 Sec. 34	Found 3/2" Iron Pipe	Same as 21 August, 1980			

Legend:  
 \* Indicates Previously Used

2