

# SURVEY & REMONUMENTATION

MAY - 1 1995

COMMISSION

## LAND CORNER RECORDATION CERTIFICATE Filing Requirement of Act 74, Mich. P.A. 1970

For corners in

<u>WASHTENAW</u> <small>(County)</small>	Located In:	Corner Code #	
1. Public Land Survey	T <u>1 S</u> R <u>5 E</u>	<u>K-9</u>	
	T _____ R _____	_____	
	T _____ R _____	_____	
	T _____ R _____	_____	
2. Property Controlling in Section	S _____ T _____ R _____	_____	
	S _____ T _____ R _____	_____	
3. Miscellaneous Property in Sec.	S _____ T _____ R _____	_____	
	S _____ T _____ R _____	_____	
4. Lot No. _____, Recorded Plat _____			
5. Private Claims _____			

RECORDED  
 WASHTENAW COUNTY, MI  
 DEC 1 11 34 AM '94  
 1 PAGE 175 RM  
 - Copy -  
 LIBER  
 Register of Deeds Stamp & File Number

I, I. JOHN JEKABSON, in a field survey on 26 OCTOBER, 19 93, do hereby certify that under requirements of P.A. 74, Michigan P.A. of 1970, the corner points mentioned in lines 1 and 2 above were in conformance with regulations and rules therefore as required in the current manual of survey instructions of the United States Department of the Interior, Bureau of Land Management or by a decree of a Court of Law and/or that the corner points mentioned in lines 3, 4 and 5 above were in conformance with the rules of the Michigan Board of Land Surveyors or by a Decree of a Court of Law; established, re-established, monumented, re-monumented, recovered, found as expressed below:

	A	B	C	D	E	F	G	H	I	J	K	L	M
2	6		5		4		3		2		1		
3													
4	7		8		9		10		11		12		
5													
6	18		17		16		15		14		13		
7													
8	19		20		21		22		23		24		
9													
10	30		29		28		27		26		25		
11													
12	31		32		33		34		35		36		
13													

**NOTE: Not more than 4 corners, all in the same town and range, may be recorded on this certificate.**

**A. Description of original monument and accessories and/or subsequent restoration:**

1819	G.L.O	Set Post	Aspin 16	S 9 W	150
	WAMPLER		B. O. 4	N 67 E	36

Date Unknown	WASHTENAW	Found wood stake.	W. Oak 32"	North	89.3	a
COUNTY ROAD COMMISSION		Set 1 1/2" x 40" Iron Pipe.	Cherry 4"	West	21.6	b
W.J. ARMSTRONG #2444			Locust 5"	West	81.3	c

SEE BACK OF THIS SHEET (NEXT PAGE) FOR CONTINUATION OF SECTION "A"


**B. Description of corner evidence found and/or method applied in restoring or reestablishing corner:**

FOUND 1" IRON PIPE IN STONES & BRICKS  
USING 5 WITNESSES FROM SECTION "A"

**C. Description of monument for corner and accessories established to perpetuate locating the position of the corner:**

Set Alum. Remon. Cap	38" Locust (PK & RT N sd.)	West	80.64	c
on 1" Iron Pipe	14" Cherry (PK & RT W sd.)	N 05° W	20.44	e
	50" White Oak (Spike & RT E sd.)	N 02° E	89.30	a
	12" Cherry (nail SE sd.)	N 30° E	2.57	d
	12" Cherry (PK & RT S sd.)	N 75° E	5.17	f
	28" Locust (PK & RT S sd.)	S 87° W	60.93	h

*I conclude that after careful study of the record documentation and field observations, that this corner is a careful and faithful perpetuation of the position of the original corner.*

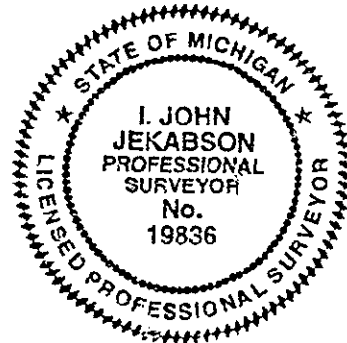

Signed by I. John Jekabson Date 6 October, 1994

Surveyor's Michigan License No. 19836

copy

Continuation of section "A"

1993 WASHTENAW COUNTY REMONUMENTATION PROGRAM

WEBSTER TOWNSHIP TOWN 1 SOUTH, RANGE 5 EAST  
K-9 (SECTION CORNER COMMON TO SECTIONS 23, 24, 26, & 25)

History compiled by:  
I. John Jekabson P.S. # 19836  
Roskelly, Jekabson & Assoc. P.C.

LIBER	DATE	COMPANY SURVEYOR JOB #	P.S. #	P.A. 74 L.C.R.C.	LOCATION OF SURVEY	MONUMENT DESCRIPTION	WITNESSES	WITNESS ID	COMMENT
	1971 23 Sept.	ATWELL-HICKS, INC. JOHN L. SNYDER Job # 27305	#13352		S.E. 1/4 SEC. 23	Found 1 1/2" Iron Pipe	48" Oak 20" Cherry Stump 20" Locust 8" Cherry	a b c d	North 89.3 West 21.6 West 81.3 N 30° E 3.0
	1972 10 April	ATWELL-HICKS, INC. JOHN L. SNYDER Job # 27593	#13352		S.E. 1/4 SEC. 23	Found 1 1/2" Iron Pipe	Same as 1971, 23 Sept.		
	1973 13 Feb.	WASHTENAW ENG. CO. NORMAN N. FAHRNER Job # 9736	#17620		S.E. 1/4 SEC. 23	Found 1 1/2" Iron Pipe	Same as 1971, 23 Sept. ATWELL-HICKS, INC.		
	1982 27 July	WASHTENAW ENG. CO. NORMAN N. FAHRNER Job # 18304	#17620		S.W. 1/4 SEC. 24	Found 1 1/2" Iron Pipe	10" Wild Cherry to nail 9" Wild Cherry to nail 4" Elm to nail	e f g	North 20.46 N 75° E 5.17 S 35° W 5.95

APPROVED  
DATE 2/8/94  
CO. REP. KA

7