SURVEY &
REMONUMENTATION

MAY - 1 1995

COMMISSION

LAND CORNER RECORDATION CERTIFICATE

Filing Requirement of Act 74, Mich. P.A. 1970

RECORDED
WASHTENAW COUNTY, MI
DEC 1 11 35 AM '94
PEGGY M. HAINES
COUNTY CLERK/REGISTER
- Copy -

LIBER 1 PAGE 178 RM
- Copy -
Register of Deeds Stamp & File Number

For corners in

WASHTENAW
(County)

	Located In:	Corner Code ##
1. Public Land Survey	T 1 S R 5 E	K - 11
	T ___ R ___	
	T ___ R ___	
	T ___ R ___	
2. Property Controlling	S ___ T ___ R ___	
in Section	S ___ T ___ R ___	
3. Miscellaneous	S ___ T ___ R ___	
Property in Sec.	S ___ T ___ R ___	

4. Lot No. _____ , Recorded Plat _____
5. Private Claims _____

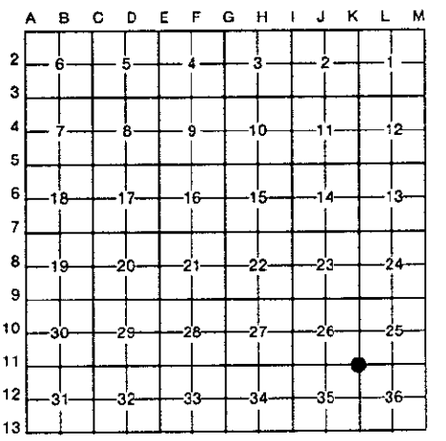

I, I. JOHN JEKABSON, in a field survey on 26 OCTOBER, 19 93, do hereby certify that under requirements of P.A. 74, Michigan P.A. of 1970, the corner points mentioned in lines 1 and 2 above were in conformance with regulations and rules therefore as required in the current manual of survey instructions of the United States Department of the Interior, Bureau of Land Management or by a decree of a Court of Law and/or that the corner points mentioned in lines 3, 4 and 5 above were in conformance with the rules of the Michigan Board of Land Surveyors or by a Decree of a Court of Law; established, re-established, monumented, re-monumented, recovered, found as expressed below:

NOTE: Not more than 4 corners, all in the same town and range, may be recorded on this certificate.

A. Description of original monument and accessories and/or subsequent restoration:

1819 G.L.O Set post B.O. 28 N 68¼ W 5.31

1935 11July WASH. CO. RD. COMM
W.J. ARMSTRONG #2444
Drove iron pipe into old wood stake

Elm, 54"	N 10° E	35.4	a
Elm, 4"	S 63½°E	87.5	b
W. Oak, 10"	S 39½°W	49.8	c
Elm, 18"	S 45° W	38.9	d
Cherry, 5"	N 71½°W	100.3	e

Found the corner set by J.B. Davis which was a wood stake, stones and bricks. Did not remove the monument but drove an iron pipe into the old wood stake.

1987 29 Dec. WASH. ENG. CO
T.L. SUTHERLAND #24620
Job # 21742
Found 1½" Iron Pipe

10" Elm to nail	S 52° E	49.14	f
26" Oak to nail	S 40° W	49.86	c
8" Cedar to nail	N 62° W	91.77	g
Power Pole to nail	N 11° E	24.80	h

B. Description of corner evidence found and/or method applied in restoring or reestablishing corner:

FOUND 1½" IRON PIPE WITH BRICKS AND STONES AROUND IT,
1 FT. BELOW GRAVEL SURFACE
USING 3 OF ABOVE WITNESSES

APPROVED
DATE 2/8/94
CO. REP. KA

C. Description of monument for corner and accessories established to perpetuate locating the position of the corner:

Set Alum. Remon. Cap on 1½" Iron Pipe

Twin 6" Cedar (nail N sd.)	N 70° W	91.75	g
D.E. Pole (nail & R.T. W. sd.)	N 05° E	24.80	h
C/L 4" Steel Fence Post	N 20° E	34.68	i
D.E. Pole (nail & R.T. S. sd.)	N 80° E	205.67	j
30" Burr Oak (PK & RT SE sd.)	S 40° W	49.80	c
36" Burr Oak (PK & RT S sd.)	S 70° W	111.38	k

STATE OF MICHIGAN
I. JOHN JEKABSON
PROFESSIONAL SURVEYOR
No. 19836
LICENSED PROFESSIONAL SURVEYOR

I conclude that after careful study of the record documentation and field observations, that this corner is accepted as the best available evidence of the position of the original corner.

Signed by I. John Jekabson Date 28 September, 1994

Surveyor's Michigan License No. 19836

FORM APPROVED BY MICHIGAN STATE BOARD OF LAND SURVEYORS, JAN. 26, 1971
REVISED MAY 14, 1975
REVISED JAN., 1983