

SURVEY &  
REMONUMENTATION

MAY - 1 1995

COMMISSION LAND CORNER RECORDATION CERTIFICATE  
Filing Requirement of Act 74, Mich. P.A. 1970

For corners in

|                                       |                           |               |
|---------------------------------------|---------------------------|---------------|
| <u>WASHTENAW</u><br>(County)          | Located In:               | Corner Code # |
| 1. Public Land Survey                 | T <u>1</u> S R <u>5</u> E | <u>L-11</u>   |
|                                       | T _____ R _____           | _____         |
|                                       | T _____ R _____           | _____         |
|                                       | T _____ R _____           | _____         |
| 2. Property Controlling<br>in Section | S _____ T _____ R _____   | _____         |
|                                       | S _____ T _____ R _____   | _____         |
| 3. Miscellaneous<br>Property in Sec.  | S _____ T _____ R _____   | _____         |
|                                       | S _____ T _____ R _____   | _____         |

LIBER 1 PAGE 185 R  
-copy-  
RECORDED  
WASHTENAW COUNTY, MI  
DEC 1 11 36 AM '94  
PEGGY M. HAINES  
COUNTY CLERK/REGISTRAR

Register of Deeds Stamp & File Number

4. Lot No. \_\_\_\_\_, Recorded Plat \_\_\_\_\_  
5. Private Claims \_\_\_\_\_

| A  | B  | C  | D  | E  | F  | G  | H | I | J | K | L |
|----|----|----|----|----|----|----|---|---|---|---|---|
| 2  | 6  | 5  | 4  | 3  | 2  | 1  |   |   |   |   |   |
| 3  |    |    |    |    |    |    |   |   |   |   |   |
| 4  | 7  | 8  | 9  | 10 | 11 | 12 |   |   |   |   |   |
| 5  |    |    |    |    |    |    |   |   |   |   |   |
| 6  | 18 | 17 | 16 | 15 | 14 | 13 |   |   |   |   |   |
| 7  |    |    |    |    |    |    |   |   |   |   |   |
| 8  | 19 | 20 | 21 | 22 | 23 | 24 |   |   |   |   |   |
| 9  |    |    |    |    |    |    |   |   |   |   |   |
| 10 | 30 | 29 | 28 | 27 | 26 | 25 |   |   |   |   |   |
| 11 |    |    |    |    |    |    |   |   |   |   |   |
| 12 | 31 | 32 | 33 | 34 | 35 | 36 |   |   |   |   |   |
| 13 |    |    |    |    |    |    |   |   |   |   |   |

I, I. JOHN JEKABSON, in a field survey on 26 OCTOBER, 19 93, do hereby certify that under requirements of P.A. 74, Michigan P.A. of 1970, the corner points mentioned in lines 1 and 2 above were in conformance with regulations and rules therefore as required in the current manual of survey instructions of the United States Department of the Interior, Bureau of Land Management or by a decree of a Court of Law and/or that the corner points mentioned in lines 3, 4 and 5 above were in conformance with the rules of the Michigan Board of Land Surveyors or by a Decree of a Court of Law; established, re-established, monumented, re-monumented, recovered, found as expressed below:

NOTE: Not more than 4 corners, all in the same town and range, may be recorded on this certificate.

A. Description of original monument and accessories and/or subsequent restoration:

|      |         |                        |                                  |               |         |       |   |
|------|---------|------------------------|----------------------------------|---------------|---------|-------|---|
| 1819 | G.L.O.  | Set post               | W. O. 28"                        | S 61° E       | 150     |       |   |
|      | WAMPLER |                        |                                  |               |         |       |   |
| 1937 | 24 Aug. | WASHTENAW              | Found old wood stake and stone.  | Burr Oak, 10" | N 68° E | 60.1  | A |
|      |         | COUNTY ROAD COMMISSION | Set iron pipe stones, and bricks | Burr Oak, 6"  | S 73° E | 112.0 | B |
|      |         | W.J. ARMSTRONG #2444   |                                  | Burr Oak, 6"  | S 45° E | 53.4  | C |
|      |         |                        |                                  | Burr Oak, 10" | S 31° E | 40.7  | D |
|      |         |                        |                                  | Burr Oak, 6"  | S 55° W | 44.0  | E |
|      |         |                        |                                  | Burr Oak, 4"  | N 23° W | 31.2  | F |

SEE BACK OF THIS SHEET (NEXT PAGE) FOR CONTINUATION OF SECTION "A"


B. Description of corner evidence found and/or method applied in restoring or reestablishing corner:

FOUND 1 1/2" IRON PIPE WITH BRICKS 2'  
BELOW THE GRAVEL SURFACE OF  
NORTHFIELD-CHURCH RD.  
USING 5 WITNESSES FROM SECTION "A"

C. Description of monument for corner and accessories established to perpetuate locating the position of the corner:

|                       |                                |         |        |   |
|-----------------------|--------------------------------|---------|--------|---|
| SET 1" IRON PIPE WITH | Nail in D.E. Pole              | N 80° W | 121.16 | G |
| ALUM. REMON. CAP      | C/L 3"x4" Steel Fence Post     | NORTH   | 32.88  | H |
| 6" BELOW GRAVEL       | PK & RT in SE sd. 24" Burr Oak | N 65° E | 60.10  | A |
| SURFACE               | PK & RT in NE sd. 22" Burr Oak | S 45° E | 53.40  | C |
|                       | PK & RT in NE sd. 30" Burr Oak | S 30° E | 40.38  | D |
|                       | PK & RT in NW sd. 20" Burr Oak | S 55° W | 44.08  | E |

I conclude that after careful study of the record documentation and field observations, that the corner is a careful and faithful perpetuation of the position of the original corner.

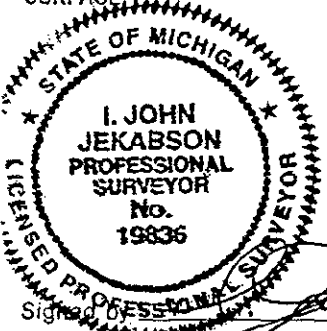

Signed by I. John Jekabson  
Surveyor's Michigan License No. 19836

Date 7 October, 1994

*copy*

1993 WASHTENAW COUNTY REMONUMENTATION PROGRAM

WEBSTER TOWNSHIP TOWN 1 SOUTH, RANGE 5 EAST  
L-11 (1/4 CORNER COMMON TO SECTION 25 & SECTION 36)

History compiled by:

I. John Jekabson P.S. # 19836  
Roskelly, Jekabson & Assoc. P.C.

| DATE            | COMPANY SURVEYOR JOB #  | P.S. # | P.A. 74 L.C.R.C. | LOCATION OF SURVEY | MONUMENT DESCRIPTION | WITNESSES  | BEARING & DISTANCE  | WITNESS ID       | COMMENT |
|-----------------|---|--------|------------------|--------------------|----------------------|--|---|------------------|---------|
| 1977 31 October | ROSKELLY, JEKABSON & ASSOC., P.C.<br>ROBERT P. ROSKELLY<br>Job # 77-10-60 | #18663 |                  | N.E. 1/4 SEC. 25   | Found Iron Pipe      | Nail in 22" White Oak<br>Nail in 30" White Oak<br>Nail in 18" White Oak<br>Nail in D.E. Pole | N 65° E 60.01<br>S 30° E 40.36<br>S 50° W 44.09<br>N 75° W 121.16 | A<br>D<br>E<br>G |         |
| 1980 27 October | ROSKELLY, JEKABSON & ASSOC., P.C.<br>ROBERT P. ROSKELLY                   | #18663 | Liber 6, Page 44 |                    | Found Iron Pipe      | Nail in 22" White Oak<br>Nail in 30" White Oak<br>Nail in 18" White Oak<br>Nail in D.E. Pole | N 65° E 60.01<br>S 30° E 40.36<br>S 50° W 44.09<br>N 75° W 121.16 | A<br>D<br>E<br>G |         |

APPROVED  
DATE 3/22/94  
O. REP. *[Signature]*