

LAND CORNER RECORDATION CERTIFICATE
Filing Requirement of Act 74, Mich. P.A. 1970

REL. 5/13/2000
 MAY 13 2000

For corners in

WASHTENAW
 (County)

Located In:

Corner Code -#

SECTION

1. Public Land Survey T 1 S R 6 E
 T ___ R ___
 T ___ R ___
 T ___ R ___
 T ___ R ___
2. Property Controlling S ___ T ___ R ___
 in Section S ___ T ___ R ___
3. Miscellaneous S ___ T ___ R ___
 Property in Sec. S ___ T ___ R ___

Northfield Twp.
E - 13



5094741
 Page: 1 of 2
 02/07/2000 02:55P

Peggy M. Haines - Washtenaw Co. CORREM L-3 P-4

Register of Deeds Stamp & File Number

4. Lot No. _____, Recorded Plat _____
 5. Private Claims _____

	A	B	C	D	E	F	G	H	I	J	K
2	6	5	4	3	2						
3											
4	7	8	9	10	11						
5											
6	18	17	16	15	14						
7											
8	19	20	21	22	23						
9											
10	30	29	28	27	26						
11											
12	31	32	33	34	35						
13											

I, I. JOHN JEKABSON, in a field survey on 12 July, 1999, do hereby certify that under requirements of P.A. 74, Michigan P.A. of 1970, the corner points mentioned in lines 1 and 2 above were in conformance with regulations and rules therefore as required in the current manual of survey instructions of the United States Department of the Interior, Bureau of Land Management or by a decree of a Court of Law and/or that the corner points mentioned in lines 3, 4 and 5 above were in conformance with the rules of the Michigan Board of Land Surveyors or by a Decree of a Court of Law; established, re-established, monumented, re-monumented, recovered, found as expressed below:

NOTE: Not more than 4 corners, all in the same town and range, may be recorded on this certificate.

A. Description of original monument and accessories and/or subsequent restoration:


1819 G.L.O. - T. Wampler SET POST
 Deputy Surveyor

1932, 30 Sept. WASHTENAW CO. ROAD COMMISSION W.J. ARMSTRONG #2444	Found of 1"x14" pipe surrounded by bricks and stones. Reset with a 2"x48" iron pipe and put stones and bricks around it.	Locust, 10" Apple, 12" Cherry, 10" Locust, 10" N. Post A.A.	N 02°W 29.5 N 32°E 81.2 S 77°W 104.9 N 57°W 58.4 West 453.4	1 2 3 4 5
---	--	---	---	-----------------------

SEE BACK OF THIS SHEET (NEXT PAGE) FOR CONTINUATION OF SECTION "A"

B. Description of corner evidence found and/or method applied in restoring or reestablishing corner:

FOUND 2"x38" IRON PIPE WITH BRICKS, 5" BELOW GRAVEL SURFACE OF JOY ROAD. THE PIPE WAS SLIGHTLY BENT IN THE TOP 8". WE CUT THE BENT 8" PORTION OFF AND SET A 3/4"x24" IRON PIPE IN IT. SET A REMON CAP 6" BELOW GRAVEL SURFACE.
 USING 5 WITNESSES FROM SECTION "A"

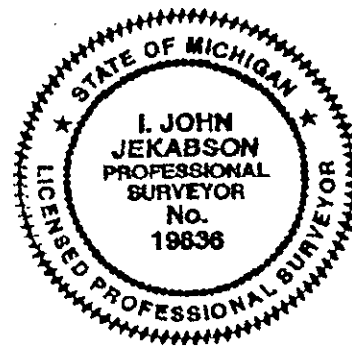

C. Description of monument for corner and accessories established to perpetuate locating the position of the corner:

SET A 3/4"x24" IRON PIPE IN THE EXISTING 2"x38" PIPE. SET REMON CAP 6" BELOW GRAVEL SURFACE.	Mag & RT in SW sd 12" Mulberry Mag & RT in SE sd 13" Locust Mag & RT in NE sd 12" Elm Mag & RT in NW sd 8" Locust Center Dead 18" Locust Prone Fence Post Center Dead Tree Center Dead Tree	N 50°W 39.18 N 50°E 42.00 S 30°E 37.70 S 20°W 28.00 North 29.0 North 32' S 40°W 31' S 60°W 49'	13 11* 14 15 1* 12* 7* 8*
--	--	---	--

Legend:
 Mag & RT = Magnetized Nail & Washtenaw Co. Remon. Tag
 * Indicates Previously Used

I conclude that after careful study of the record documentation and field observations, that this corner is a careful and faithful perpetuation of the position of the original corner.

Signed by I. John Jekabson Date 22 November, 1999
 Surveyor's Michigan License No. 19836

FORM APPROVED BY MICHIGAN STATE BOARD OF LAND SURVEYORS, J. REVISED N. REVISE

APPROVED
 DATE 9/13/99
 CO. REP. Ka

CONTINUATION OF SECTION "A"

1999 WASHTENAW COUNTY REMONUMENTATION PROGRAM
 NORTHFIELD TOWNSHIP TOWN 1 SOUTH, RANGE 6 EAST
 E-13 (S.E. CORNER OF SEC. 32 & S.W. CORNER SEC. 33)

History compiled by:
 I. John Jekabson P.S. # 19836
 Jekabson & Associates, P.C.

DATE	COMPANY SURVEYOR & P.S. #	JOB. #	P.A. 74 L.C.R.C.	LOCATION OF SURVEY	MONUMENT DESCRIPTION	WITNESSES	BEARING & DISTANCE	ID #	COMMENT
Unknown	WASHTENAW CO. ROAD COMMISSION Grid Book (hand written)				Iron Pipe	17' Locust 5" Elm 12" Locust 9" Locust	North 29.18 N 30°W 32.44 S 40°W 31.03 S 60°W 49.13	1* 6 7 8	
1964, 23 June 1981, 24 Feb.	ATWELL-HICKS, INC. JERRY L. WILCOX #14102	22648		SW 1/4 Sec 33	Found Iron Pipe Found 2" Iron Pipe	No Witnesses 17' Locust (face blazes; of record) 4" Twin Wild Cherry 4" Elm 12" Locust	North 29.18 S 18°W 31.40 S 50°E 52.02 N 40°E 42.00	1* 9 10 11	
1981, 4 Nov.	GREG L. ASH #28400				Found 2" Iron Pipe	Nail in 12" Tree Nail in 5" Tree Nail in Twin Cherry Center of Corner Fence Post	N 60°E 42.0 S 75°E 52.1 S 45°W 31.2 North 31.8	11* 10* 9* 12	

* Indicates Previously Used



5094741
 Page: 2 of 2
 02/07/2000 02:55P

Peggy M. Haines - Washtenaw Co. CORREM L-3 P-5

SURVEYOR
 JERRY L. WILCOX

MAY 18 2000

SECTION