

RECEIVED
MAY 10 2000

LAND CORNER RECORDATION CERTIFICATE
Filing Requirement of Act 74, Mich. P.A. 1970

For corners in SECTION

WASHTENAW
(County)

Located In:

Corner Code #

Northfield Twp.
F - 09

- 1. Public Land Survey T 1 S R 6 E
- T R
- T R
- T R
- 2. Property Controlling S T R
- in Section S T R
- 3. Miscellaneous S T R
- Property in Sec. S T R




5094742
Page: 1 of 2
02/07/2000 02:55P

Peggy M. Haines - Washtenaw Co. CORREM L-3 P-6

Register of Deeds Stamp & File Number

- 4. Lot No. _____, Recorded Plat _____
- 5. Private Claims _____

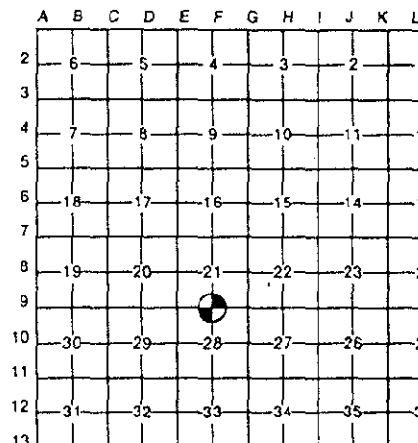

I, JOHN JEKABSON, in a field survey on 14 July, 1999, do hereby certify that under requirements of P.A. 74, Michigan P.A. of 1970, the corner points mentioned in lines 1 and 2 above were in conformance with regulations and rules therefore as required in the current manual of survey instructions of the United States Department of the Interior, Bureau of Land Management or by a decree of a Court of Law and/or that the corner points mentioned in lines 3, 4 and 5 above were in conformance with the rules of the Michigan Board of Land Surveyors or by a Decree of a Court of Law; established, re-established, monumented, re-monumented, recovered, found as expressed below:

NOTE: Not more than 4 corners, all in the same town and range, may be recorded on this certificate.

A. Description of original monument and accessories and/or subsequent restoration:

1819 G.L.O. - T. Wampler SET POST
Deputy Surveyor

1935, 15 Aug. WASHTENAW CO. ROAD	Found an old wood stake.	White Oak, 30"	East	87.0	1
COMMISSION W.J. ARMSTRONG #2444	Reset with a 1 1/2"x36" Iron Pipe with stones and bricks around it	White Oak, 36"	S 67°W	139.6	2
		White Oak, 36'	N 74 1/2°W	129.3	3
		Swamp Oak, 36"	N 56°W	147.2	4
		Top of Big Boulder,	S 15 1/2°W	22.4	5

SEE BACK OF THIS SHEET (NEXT PAGE)
FOR CONTINUATION OF SECTION "A"

B. Description of corner evidence found and/or method applied in restoring or reestablishing corner:

FOUND 1/2"x24" IRON PIPE 3" BELOW THE GROUND WITH STONES & BRICKS SURROUNDING IT. PULLED THE PIPE, RECEIVED NO FURTHER READING. REPLACED WITH A 1 1/2"x36" IRON PIPE. SET A REMON CAP 3" ABOVE SURFACE.

USING 6 WITNESSES FROM SECTION "A"



C. Description of monument for corner and accessories established to perpetuate locating the position of the corner:

SET A 1 1/2"x36" IRON PIPE WITH REMON CAP 3" ABOVE SURFACE.	Mag & RT in S sd 42" White Oak	N 70°W	129.09	3*
	Mag & RT in SW sd 13" Locust	N 48°E	55.04	8*
	Mag & RT in SE sd Utility Pole	N 34°E	222.88	11
	Nail in SW sd 42" Burr Oak	N 60°W	147.20	4*
	SW Corner of Garage	N 08°W	102.22	6*
	SE Corner of Garage	N 12°E	95.94	12
	Center of Utility Pole	N 80°E	92.0	7*
	1" Iron Pipe in gravel of Nollar Road	West	147.23	10*

Legend:
Mag & RT = Magnetized Nail & Washtenaw Co. Remon. Tag
* Indicates Previously Used

I conclude that after careful study of the record documentation and field observations, that this corner is a careful and faithful perpetuation of the position of the original corner.

Signed by [Signature] Date 22 November, 1999
Surveyor's Michigan License No. 19836

FORM APPROVED BY MICHIGAN STATE BOARD OF LAND SURVEYORS, JAN
REVISED MAY
REVISED J

APPROVED
DATE 9/13/99
CO. REP. K

CONTINUATION OF SECTION "A"

1998 WASHTENAW COUNTY REMONUMENTATION PROGRAM
NORTHFIELD TOWNSHIP TOWN 1 SOUTH, RANGE 6 EAST
F-9 (1/4 CORNER COMMON TO SECTIONS 21 & 28)

History compiled by:
I. John Jekabson P.S. # 19836
Jekabson & Associates, P.C.

DATE	COMPANY SURVEYOR & P.S. #	JOB. #	P.A. 74 L.C.R.C.	LOCATION OF SURVEY	MONUMENT DESCRIPTION	WITNESSES	BEARING & DISTANCE	ID #	COMMENT
1963, 28 Oct.	ATWELL-HICKS, INC.	22074		N 1/4 Sec 28	Found Iron Pipe	No Witnesses			
1964, 8 July	ATWELL-HICKS, INC.	22523		N 1/4 Sec 28	Found Iron Pipe	No Witnesses			
1965, 4 Aug.	ATWELL-HICKS, INC.	23567		N 1/4 Sec 28	Found Iron Pipe	No Witnesses			
1970, 19 Jan.	ATWELL-HICKS, INC.	30202		NW 1/4 Sec 28	No Indication	No Witnesses			
1970, 16 Feb.	ATWELL-HICKS, INC.	30202		Section 28	No Indication	No Witnesses			
1971, 23 Dec.	ATWELL-HICKS, INC. ROBERT J. JAGOW #6988	27427		S 1/4 Sec 21	Found 1/2" Iron Pipe	48" White Oak 48" Swamp Oak S.W. Corner Garage Pole	N 74°W 129.3 N 56°W 147.2 N 30°W 102.2 N 80°E 92.0	3* 4* 6 7	
1972, 26 April	ATWELL-HICKS, INC. JOHN L. SNYDER # 13352	27683		S 1/4 Sec 21	Found 1/2" Iron Pipe	Same as 1971, 23 Dec. (A-H)			
1972, 9 May	WASHTENAW ENGINEERING CO., INC. NORMAN N. FAHRNER #17620		Liber 1, Page 637		Found 1/2" Iron Pipe	40" W. Oak 40" Oak Power Pole SW Corner of Garage	N 53°W 129.3 N 72°W 147.2 N 85°E 92.2 N 10°W 102.4	3* 4* 7* 6*	
1972, 5 Aug.	WASHTENAW ENGINEERING CO., INC. NORMAN N. FAHRNER #17620	13095		N 1/4 Sec 28	Found 1/2" Iron Pipe	Same as 1972, 9 May (WE)			
1978, 18 Sept.	ATWELL-HICKS, INC. JOHN L. SNYDER # 13352	32657		SW 1/4 Sec 21	Found 1/2" Iron Pipe	Same as 1971, 23 Dec. (A-H)			
1980, 16 May	WASHTENAW ENGINEERING CO., INC. NORMAN N. FAHRNER #17620	17519		SW 1/4 Sec 21	Found 1/2" Iron Pipe	Same as 1972, 9 May (WE)			
1987, 17 June	LAND SURVEYING CONSULTANTS R. TIMOTHY TIETSEMA # 20712	17386		SW 1/4 Sec 21	Found	P.P. 12" Locust 18" Chin. Elm	S 83°E 92.04 N 47°W 55.13 N 20°E 70.69	7* 8 9	
1989, 28 Mar.	ATWELL-HICKS, INC. ROBERT G. MACOMBER # 27453	38299		S 1/4 Sec 21	Found 1/2" Iron Pipe	Same as 1971, 23 Dec. (A-H)			
1990, 1 Nov.	MIDWESTERN CONSULTING Field Notes	90164			FIP	PK sw/d. 12" Elm PK w/d. Triple 8" Elm Nail s/d. U.P.	N 60°W 55.12 N 15°E 70.17 N 85°E 92.10	8* 9* 7*	
1991, 12 Feb.	ROSKELLY, JEKABSON & ASSOC., P.C. I. JOHN JEKABSON # 19836	91-1-30		Sec 28	Found 1/2" Iron Pipe	Nail in Utility Pole 1" Iron Pipe Nail in 48" White Oak Nail in 48" Burr Oak	N 80°E 92.00 Westerly 147.25 N 74°W 129.30 N 56°W 147.20 N 30°W 102.20	7* 10 3* 4* 6*	
1991, 20 June	ROSKELLY, JEKABSON & ASSOC., P.C. I. JOHN JEKABSON # 19836	91-2-55		N 1/4 Sec 28	Found 1/2" Iron Pipe	SW Corner of Garage Same as 1991, 12 Feb. (R&J)			
1991, 4 Nov.	ATWELL-HICKS, INC. ROBERT G. MACOMBER # 27453	39670		SW 1/4 Sec 21	Found Iron Pipe	No Witness			

* Indicates Previously Used



Peggy M. Haines - Washtenaw Co. CORREM

5094742
Page: 2 of 2
02/07/2000 02:55P
L-3 P-7

SEARCHED
SERIALIZED
INDEXED

MAY 03 2000

SECTION

Copy -