

SECTION

LAND CORNER RECORDATION CERTIFICATE
Filing Requirement of Act 74, Mich. P.A. 1970

For corners in

WASHTENAW (County)


Located In:

Corner Code #

1. Public Land Survey

T 1 S R 6 E

Northfield Twp. F-13

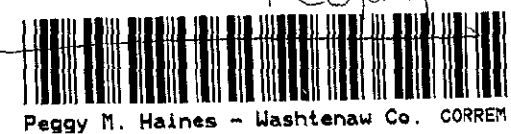

5094744 Page: 1 of 2 02/07/2000 02:55P

2. Property Controlling in Section

S T R S T R

3. Miscellaneous Property in Sec.

S T R S T R

Register of Deeds Stamp & File Num

4. Lot No. , Recorded Plat
5. Private Claims

Grid table with columns A-J and rows 2-13

I, JOHN JEKABSON, in a field survey on 12 July, 1999, do hereby certify that under requirements of P.A. 74, Michigan P.A. of 1970, the corner points mentioned in lines 1 and 2 above were in conformance with regulations and rules therefore as required in the current manual of survey instructions of the United States Department of the Interior, Bureau of Land Management or by a decree of a Court of Law and/or that the corner points mentioned in lines 3, 4 and 5 above were in conformance with the rules of the Michigan Board of Land Surveyors or by a Decree of a Court of Law; established, re-established, monumented, re-monumented, recovered, found as expressed below:

NOTE: Not more than 4 corners, all in the same town and range, may be recorded on this certificate.

A. Description of original monument and accessories and/or subsequent restoration:

1819 G.L.O. - T. Wampler SET POST Deputy Surveyor


Table with 4 columns: Description, Material, Bearing, Distance

SEE BACK OF THIS SHEET (NEXT PAGE) FOR CONTINUATION OF SECTION "A"

B. Description of corner evidence found and/or method applied in restoring or reestablishing corner:

FOUND 1 1/2" X 3/8" IRON PIPE IN POOR CONDITION WITH BRICKS & STONES, 4" BELOW GRAVEL SURFACE OF JOY ROAD. REPLACED WITH A 3/4" X 24" IRON PIPE. SET A REMON CAP 6" BELOW GRAVEL SURFACE.

USING 6 WITNESSES FROM SECTION "A"

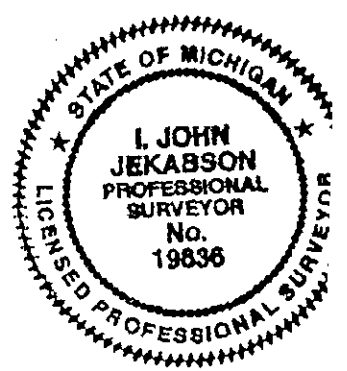

C. Description of monument for corner and accessories established to perpetuate locating the position of the corner:

Table with 4 columns: Monument Description, Bearing, Distance, Remarks

Legend: Mag & RT = Magnetized N; Washtenaw Co. Remon. * Indicates Previously Use

I conclude that after careful study of the record documentation and field observations, that this corner is accepted as the best available evidence of the position of the original corner.

Signed by [Signature] Date 22 November, 1999
Surveyor's Michigan License No. 19836

FORM APPROVED BY MICHIGAN STATE BOARD OF LAND SURVY

APPROVED DATE 9/13/99 CO. REP. KA

CONTINUATION OF SECTION "A"

1999 WASHTENAW COUNTY REMONUMENTATION PROGRAM
 NORTHFIELD TOWNSHIP TOWN 1 SOUTH, RANGE 6 EAST
 F-13 (SOUTH 1/4 CORNER SECTION 33)

History compiled by:
 I. John Jekabson P.S. # 19836
 Jekabson & Associates, P.C.

DATE	COMPANY SURVEYOR & P.S. #	JOB. #	P.A. 74 L.C.R.C.	LOCATION OF SURVEY	MONUMENT DESCRIPTION	WITNESSES	BEARING & DISTANCE	ID #	COMMENT
1963, 17 July	ATWELL-HICKS, INC.	21967		SE 1/4 Sec 33	Found Iron Pipe	No Witnesses			
1964, 23 June	ATWELL-HICKS, INC.	22648		SW 1/4 Sec 33	Found Iron Pipe	No Witnesses			
1975, 10 Mar.	WASHTENAW ENGINEERING CO., INC. CHARLES C. WILSON #13604	12762		Sec 4 Ann Arbor Twp.	1 1/2" Iron Pipe	30" Oak 12" Oak (Fly trunk) 15" Oak 10" Oak 10" Oak	N 72°W 84.0 N 50°W 38.7 S 29°W 29.2 S 05°W 25.7 N 25°E 32.6	1* 2* 5* 8 9	
1981, 24 Feb.	JERRY L. WILCOX #14102		Liber 6, Page 196		Found Iron Pipe	40" White Oak 10" Yellow Oak 6" Hickory 12" Yellow Oak	N 72°W 84.00 N 50°W 38.70 N 54°E 42.30 S 29°W 29.20 S 15°W 25.67	1* 2* 4* 5* 8*	
1996, 21 Aug.	LAND SURVEYING CONSULTANTS R. TIMOTHY TIETSBMA # 20712	07796- 196E33		SE 1/4 Sec.33	Found 1/2" Iron Pipe	12" Oak 15" Oak 8" Crabapple 18" W. Oak	S 30°W 29.19 N 15°E 23.89 N 40°E 32.43	8* 5* 10 9*	

* Indicates Previously Used

Copy -



5094744
 Page: 2 of 2
 02/07/2000 02:55P
 Peggy M. Haines - Washtenaw Co. CORREM L-3 P-11

SECTION
 MAY 10 2000
 SECTION