

REF

2000

LAND CORNER RECORDATION CERTIFICATE
Filing Requirement of Act 74, Mich. P.A. 1970

SECTION

For corners in

WASHTENAW (County)

Located In:

Corner Code #

Northfield Twp. G-9

- 1. Public Land Survey T 1 S R 6 E
2. Property Controlling in Section S T R
3. Miscellaneous Property in Sec. S T R



Page: 1 of 2
02/07/2000 02:55P

Peggy M. Haines - Washtenaw Co. CORREM L-3 P-12

Register of Deeds Stamp & File Number

- 4. Lot No. , Recorded Plat
5. Private Claims

Grid table with columns A-K and rows 2-13. A dot is marked at row 9, column H.

I, JOHN JEKABSON, in a field survey on 14 July, 1999, do hereby certify that under requirements of P.A. 74, Michigan P.A. of 1970, the corner points mentioned in lines 1 and 2 above were in conformance with regulations and rules therefor as required in the current manual of survey instructions of the United States Department of the Interior, Bureau of Land Management or by a decree of a Court of Law and/or that the corner points mentioned in lines 3, 4 and 5 above were in conformance with the rules of the Michigan Board of Land Surveyors or by a Decree of a Court of Law, established, re-established, monumented, re-monumented, recovered, found as expressed below:

NOTE: Not more than 4 corners, all in the same town and range, may be recorded on this certificate.

A. Description of original monument and accessories and/or subsequent restoration:
1819 G.L.O. - T. Wampler SET POST
Deputy Surveyor


Table with 4 columns: Description, Monument, Bearing, Distance. Includes entries for Aspen, White Oak, and Hickory.

SEE BACK OF THIS SHEET (NEXT PAGE) FOR CONTINUATION OF SECTION "A"

B. Description of corner evidence found and/or method applied in restoring or reestablishing corner:

FOUND 1 1/2" X 36" IRON PIPE SURROUNDED BY STONES & BRICKS. THE PIPE'S TOP WAS MUSHROOMED AND IN POOR CONDITION. PULLED THE PIPE, RECEIVED NO FURTHER READING. REPLACED WITH A 1 1/2" X 36" IRON PIPE. SET A REMON CAP 4" ABOVE SURFACE. THE STONES & BRICKS STILL REMAIN.

USING 5 WITNESSES FROM SECTION "A"

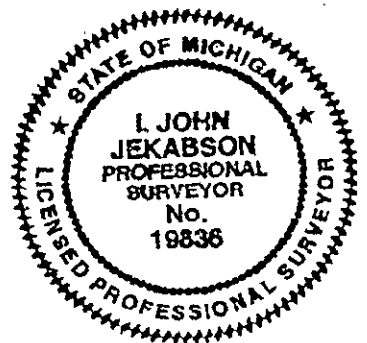

C. Description of monument for corner and accessories established to perpetuate locating the position of the corner:

Table with 4 columns: Description, Monument, Bearing, Distance. Includes entries for Shagbark Hickory, Poplar, Cherry, White Oak, and East-West Fence.

Legend:
Mag & RT = Magnetized Nail & Washtenaw Co. Remon. Tag
* Indicates Previously Used

I conclude that after careful study of the record documentation and field observations, that this corner is a careful and faithful perpetuation of the position of the original corner.

Signed by [Signature] Date 22 November, 1999
Surveyor's Michigan License No. 19836

FORM APPROVED BY MICHIGAN STATE BOARD OF LAND SURVEYORS

APPROVED DATE 9/13/99 CO. REP. [Signature]

CONTINUATION OF SECTION "A"

1999 WASHTENAW COUNTY REMONUMENTATION PROGRAM
 NORTHFIELD TOWNSHIP TOWN 1 SOUTH, RANGE 6 EAST
 G-9 (SECTION CORNER COMMON TO SECTIONS 21, 22, 27, & 28)

I. John Jekabson P.S. # 19836
 Jekabson & Associates, P.C.

History compiled by:

DATE	COMPANY SURVEYOR & P.S. #	JOB #	P.A. 74 L.C.R.C.	LOCATION OF SURVEY	MONUMENT DESCRIPTION	WITNESSES	BEARING & DISTANCE	ID #	COMMENT
1970, 16 Feb. 1971, 21 Dec.	ATWELL-HICKS, INC. ATWELL-HICKS, INC. ROBERT J. JAGOW #6998	30202	Liber 1, Page 411	Section 28	No Indication 1 1/2" Iron Pipe	No. Witnesses 10" Aspen 30" White Oak 30" White Oak 24" Hickory	N 20°E 45.5 East 99.9 S 85°W 68.5 N 89°W 41.4	5 2* 3* 4*	
1973, 19 Nov.	WASHTENAW ENGINEERING CO., INC. JOHN F. OLIVER #19840	11350		SW 1/4 Sec 22	1 1/2" Iron Pipe	10" Aspen 30" White Oak 30" White Oak 24" Hickory	N 20°E 45.5 East 99.9 S 85°W 68.5 N 89°W 41.4	5* 2* 3* 4*	
1987, 30 Nov.	ROSKELLY, JEKABSON & ASSOC., P.C. I. JOHN JEKABSON # 19836	87-11-2		SW 1/4 Sec 22	Found 1 1/2" Iron Pipe	Nail in 30" White Oak Nail in 18" Cherry Nail in 30" White Oak Nail in 24" Shag. Hickory East-West Fence	East 99.90 S 45°E 28.55 S 85°W 68.50 West 41.40 On Line ±	2* 6 3* 4* 7	
1987, Nov.	LAND SURVEYING CONSULTANTS R. TIMOTHY TIETSEMA # 20712	18787- 158E27		NW 1/4 Sec 27	Found Iron	10" Aspen 25" Hickory 32" White Oak	N 20°E 45.5 S 87°W 41.4 N 89°W 68.5	5* 4* 3*	(as previously recorded)
1989, 6 April	ROSKELLY, JEKABSON & ASSOC., P.C. I. JOHN JEKABSON # 19836	89-3-131		SE 1/4 Sec 21	Found 1 1/2" Iron Pipe	Same as 1987, 30 Nov. (R&J)			
1991, 12 Feb.	ROSKELLY, JEKABSON & ASSOC., P.C. I. JOHN JEKABSON # 19836	91-1-30		Section 28	Found 1 1/2" Iron Pipe	Same as 1987, 30 Nov. (R&J)			
1996 June	LAND SURVEYING CONSULTANTS R. TIMOTHY TIETSEMA # 20712	05796- 158E22		SW 1/4 Sec 22	Found 1 1/2" Iron Pipe	Same as 1987, Nov. (LSC)			

* Indicates Previously Used



Peggy M. Haines - Washtenaw Co. CORREM L-3 P-13

5094745
 Page: 2 of 2
 02/07/2000 02:55P

SECTION
 2000