

LAND CORNER RECORDATION CERTIFICATE
Filing Requirement of Act 74, Mich. P.A. 1970

SECTION

For corners in

WASHTENAW
(County)

Located in:

Corner Code ##

- 1. Public Land Survey T 1 S R 6 E
2. Property Controlling in Section S T R
3. Miscellaneous Property in Sec. S T R

Northfield Twp.
H-13



5094752
Page: 1 of 2
02/07/2000 02:55P

Peggy M. Haines - Washtenaw Co. CORREM L-3 P-26

Register of Deeds Stamp & File Number

- 4. Lot No. , Recorded Plat
5. Private Claims

I, JOHN JEKABSON, in a field survey on 14 July, 1999, do hereby certify that under requirements of P.A. 74, Michigan P.A. of 1970, the corner points mentioned in lines 1 and 2 above were in conformance with regulations and rules therefore as required in the current manual of survey instructions of the United States Department of the Interior, Bureau of Land Management or by a decree of a Court of Law and/or that the corner points mentioned in lines 3, 4 and 5 above were in conformance with the rules of the Michigan Board of Land Surveyors or by a Decree of a Court of Law; established, re-established, monumented, re-monumented, recovered, found as expressed below:

NOTE: Not more than 4 corners, all in the same town and range, may be recorded on this certificate.

A. Description of original monument and accessories and/or subsequent restoration:


1819 G.L.O. - T. Wampler SET POST
Deputy Surveyor

Table with 5 columns: Description, Monument, Distance, Angle, and Count. Includes entries for Apple, Hickory, Wild Cherry, and Right of Way Pipes.

SEE BACK OF THIS SHEET (NEXT PAGE) FOR CONTINUATION OF SECTION "A"

B. Description of corner evidence found and/or method applied in restoring or reestablishing corner:

FOUND A 1 1/2" X 28" IRON PIPE AT THE GRAVEL SURFACE OF JOY ROAD WITH STONES & BRICKS SURROUNDING IT. THE PIPE WAS MUSHROOMED AND IN POOR CONDITION. PULLED THIS PIPE OUT, RECEIVED NO FURTHER READING. REPLACED WITH 3/4" X 24" IRON PIPE. SET REMON CAP 6" BELOW GRAVEL SURFACE. STONES & BRICKS REMAIN.

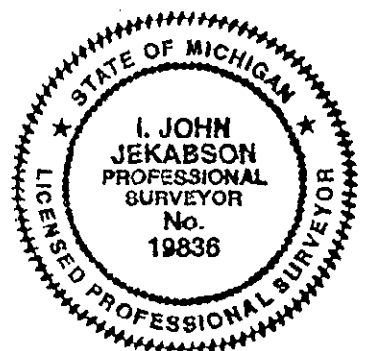

C. Description of monument for corner and accessories established to perpetuate locating the position of the corner:

Table with 5 columns: Description, Monument, Distance, Angle, and Count. Includes entries for Railroad Tie Post, Twin 13" Cherry, 18" Cherry, Elm, Dead Cherry, and 16" Cherry.

Legend:
Mag & RT = Magnetized Nail & Washtenaw Co. Remon. Tag
\* Indicates Previously Used

I conclude that after careful study of the record documentation and field observations, that this corner is a careful and faithful perpetuation of the position of the original corner.

Signed by [Signature] Date 26 November, 1999
Surveyor's Michigan License No. 19836

APPROVED
DATE 9/13/99
CO. REP. H

CONTINUATION OF SECTION 'A'

1999 WASHTENAW COUNTY REMONUMENTATION PROGRAM  
NORTHFIELD TOWNSHIP TOWN 1 SOUTH, RANGE 6 EAST  
H-13 (SOUTH 1/4 CORNER SECTION 34)

History compiled by:  
I. John Jekabson P.S. # 19836  
Jekabson & Associates, P.C.

DATE	COMPANY SURVEYOR & P.S. #	JOB #	P.A. 74 L.C.R.C.	LOCATION OF SURVEY	MONUMENT DESCRIPTION	WITNESSES	BEARING & DISTANCE	ID #	COMMENT
1951, 20 July 1977, 2 Sept.	ATWELL-HICKS, INC. JOHN McMAHON #4018	F#303-85	Liber 4, Page 354	SE 1/4 Sec 34	No indication Found Iron	No Witnesses Fence Post Fence Post 18" Tree	N 02°W 33.2 S 30°W 34.20 S 20°E 29.14	9 10 11	
1980, 29 Aug.	ATWELL-HICKS, INC. ROBERT G. MACOMBER # 27453	33778		SW 1/4 Sec 34	Found 1 1/2" Iron Pipe	Hickory 14" B. Cherry 14" B. Cherry Spike in S. side of Fence Post	S 75°E 29.8 S 10°E 46.1 S 50°E 33.15 N 02°W	11* 12 9*	
1980, 2 Oct.	ATWELL-HICKS, INC. ROBERT G. MACOMBER # 27453	33833		SW 1/4 Sec 34	Found 1 1/2" Iron Pipe	Same as 1980, 29 Aug. (A-H)			
1980, 24 Nov.	ATWELL-HICKS, INC. PAUL V. SCHWIMMER, #24818	33805		SW 1/4 Sec 34	Found 1 1/2" Iron Pipe	Same as 1980, 29 Aug. (A-H)			
1985, 7 Dec.	WASHTENAW ENGINEERING CO., INC. NORMAN N. FAHRNER #17620	20434		SE 1/4 Sec 34	Large Nail	Nail in 12" Tw. Cherry Nail in 14" Cherry Nail in 20" Cherry Nail in RR Tie Post	S 55°E 70.89 S 65°W 130.38 S 15°E 30.06 N 02°W 33.20	13 14 11* 9*	

\* Indicates Previously Used



Peggy M. Haines - Washtenaw Co. CORREM

5094752  
Page: 2 of 2  
02/07/2000 02:56P

L-3 P-27

- Copy -

SECTION

2000