

MAY 09 1996

- COPY -

COMMISSION LAND CORNER RECORDATION CERTIFICATE  
Filing Requirement of Act 74, Mich. P.A. 1970

For corners in

WASHTENAW  
(County)

Located in:

Corner Code #

- |                                    |       |       |        |
|------------------------------------|-------|-------|--------|
| 1. Public Land Survey              | T 1 S | R 6 E | K - 13 |
|                                    | T     | R     |        |
|                                    | T     | R     |        |
|                                    | T     | R     |        |
| 2. Property Controlling in Section | S     | T     | R      |
|                                    | S     | T     | R      |
| 3. Miscellaneous Property in Sec.  | S     | T     | R      |
|                                    | S     | T     | R      |
4. Lot No. \_\_\_\_\_, Recorded Plat \_\_\_\_\_
5. Private Claims \_\_\_\_\_

Register of Deeds Stamp & File Number

	A	B	C	D	E	F	G	H	I	J	K	L	M
2	8	5	4	3	2	1							
3													
4	7	8	9	10	11	12							
5													
6	18	17	16	15	14	13							
7													
8	19	20	21	22	23	24							
9													
10	30	29	28	27	26	25							
11													
12	31	32	33	34	35	36							
13													

I, I. JOHN JEKABSON, in a field survey on 20 February, 1995, do hereby certify that under requirements of P.A. 74, Michigan P.A. of 1970, the corner points mentioned in lines 1 and 2 above were in conformance with regulations and rules therefore as required in the current manual of survey instructions of the United States Department of the Interior, Bureau of Land Management or by a decree of a Court of Law and/or that the corner points mentioned in lines 3, 4 and 5 above were in conformance with the rules of the Michigan Board of Land Surveyors or by a Decree of a Court of Law; established, re-established, monumented, re-monumented, recovered, found as expressed below:

**NOTE: Not more than 4 corners, all in the same town and range, may be recorded on this certificate.**

A. Description of original monument and accessories and/or subsequent restoration:

1819 G.L.O. - SET POST	Sugar Maple, 12"	N 10° E	13 Lks
T. WAMPLER	Ash, 15"	S 11° E	37 Lks

1933 23 August WASHTENAW COUNTY ROAD COMMISSION	From stump of Pettibone's witness tree found a wood stake.	Elm, 14"	S 71° E	84.15	1
W.J. ARMSTRONG #2444	Reset with Iron Pipe, bricks and stones.	Elm, 10'	S 54½° E	30.5	2
		Elm, 3"	S 58½° W	41.9	3
		B. Walnut 3"	N 48° E	46.2	4
		3 R. of W. Pipes			5

SEE BACK OF THIS SHEET (NEXT PAGE) FOR CONTINUATION OF SECTION "A"

B. Description of corner evidence found and/or method applied in restoring or reestablishing corner:


FOUND ¾"X18" IRON PIPE 4" BELOW GRAVEL SURFACE.  
FOUND ½"X18" IRON PIPE 24" BELOW GRAVEL SURFACE.  
FOUND 1"X40" IRON PIPE AT 34" DEPTH.  
FOUND BRICK AT 48" DEPTH.

USING 3 WITNESSES FROM SECTION "A"

RECORDED  
 WASHTENAW COUNTY, MI  
 APR 29 1 29 PM '96  
 PEOP. CLERK'S REGISTER  
 - COPY -

C. Description of monument for corner and accessories established to perpetuate locating the position of the corner:

SET 1"X36" IRON PIPE, W/ REMON CAP SURROUNDED WITH ASPHALT COLD PATCH OVER 1"X40" IRON PIPE.	PK & RT in NW sd Power Pole	N 50° E	80.10	6
	6" Cedar (leaning)	S 80° E	90.5±	7
	PK & RT in S sd Power Pole	N 80° W	149.72	9
	PK & RT in S sd Power Pole	N 80° E	326.34	15
	PK & RT in N sd Tri 16" Red Oak	S 87° E	352.75	16

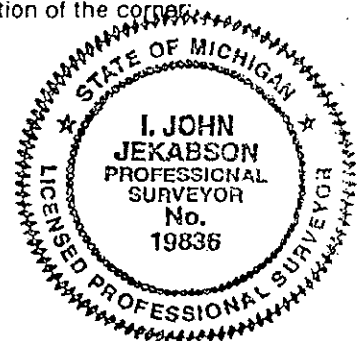

I conclude that after careful study of the record documentation and field observations, that this corner is a careful and faithful perpetuation of the position of the original corner

Signed by I. John Jekabson Date 1 DECEMBER, 1995  
Surveyor's Michigan License No. 19836

CONTINUATION OF SECTION 'A' - Copy -

1995 WASHTEENAW COUNTY REMONUMENTATION PROGRAM

NORTHFIELD TOWNSHIP TOWN 2 SOUTH, RANGE 3 EAST  
K-13 (S.E. CORNER OF SEC. 35 & S.W. CORNER OF SEC. 36)

History compiled by:  
I. John Jekabson P.S. # 19836  
Roskelly, Jekabson & Assoc. P.C.

DATE	SURVEYOR & JOB #	P.S. #	P.A. 74 L.C.R.C.	LOCATION OF SURVEY	MONUMENT DESCRIPTION	WITNESSES	BEARING & DISTANCE	ID #	COMMENT
1961 10 Nov.	DETROIT EDISON CO. J. SIERGIEJ Drawing # 5MS-894-2			LARK CORRIDOR	Found 3/4" Iron	No Witnesses			
Unknown	ATWELL-HICKS, INC. Job # 24387			S.E. 1/4 of Section 35	Found Iron	No Witnesses			
1972 5 July	WASHTEENAW ENG. CO. NORMAN N. FAHRNER	# 17620	Liber 2, Page 153	S.E. 1/4 Section 35	Found 3/4" Iron Pipe	Stump Stump Power Pole 3" Cedar	S 71° E 84.2 S 54 1/2° E 30.5 N 55° E 80.1 S 80° E 90.5	1 2 6 7	
1972 6 July	WASHTEENAW ENG. CO. NORMAN N. FAHRNER Job # 8738	# 17620		S.E. 1/4 Section 35	Found 3/4" Iron Pipe	Same as 1972, 5 July			
1978 16 Sept.	ROSKELLY, JEKABSON & ASSOC., P.C. ROBERT P. ROSKELLY Job # 78-7-106	# 18663		S.E. 1/4 Section 35	Found Iron Pipe	Nail in D.E. Pole Nail in 15" Bl. Walnut Nail in D.E. Pole Road Name Sign	NEY 80.17 S 80° W 148.15 N 80° W 149.72 N 80° W 40.9	6 8 9 10	
1978 22 Sept.	ROSKELLY, JEKABSON & ASSOC., P.C. ROBERT P. ROSKELLY Job # 78-8-269	# 18663		S.E. 1/4 Section 35	Found Iron Pipe	Same as 1978, 16 Sept			
1981 13 May	ATWELL-HICKS, INC. ROBERT G. MACCAMBER Job # 34114	# 27453		S.E. 1/4 of Section 35	Found Iron Pipe	Power Pole 6" Cedar South End 24" C.M.P. North End 24" C.M.P.	N 45° E 80.22 S 70° E 90.8 S 60° W 49.4 N 60° W 50.6	6 7 11 12	
1983 13 June	ATWELL-HICKS, INC. ROBERT G. MACCAMBER Job # 34970	# 27453		S.E. 1/4 of Section 35	Found 3/4" Iron Pipe	Same as 1981, 13 May			
1984 15 Oct.	WASHTEENAW ENG. CO. NORMAN N. FAHRNER Job # 21326	# 17620		S.E. 1/4 of Section 35	Found 3/4" Iron Pipe	Sign Post Power Pole 8" Willow 3" Cedar	N 45° W 41.23 N 55° E 80.1 S 05° W 55.23 S 80° E 90.5	10 6 13 7	
1987 15 May	WASHTEENAW ENG. CO. NORMAN N. FAHRNER Job # 21326	# 17620		S.W. 1/4 of Section 36	Found 3/4" Iron Pipe	6" Cedar Sign Post 8" Willow	S 80° E 90.5 N 35° W 50.1 S 05° W 55.23	7 14 13	
1989 1 Nov.	MIDWESTERN-CONSULTING ALLEN R. RENTSCHLER Job # 89291	# 15411		S.W. 1/4 of Section 36	No Indication	No Witnesses			
1989 15 Sept.	WASHTEENAW ENG. CO. NORMAN N. FAHRNER Job # 22365	# 17620		S.E. 1/4 of Section 35	Found 3/4" Iron Pipe	Stump Stump Power Pole 3" Cedar	S 71° E 84.15 S 54 1/2° E 30.5 N 55° E 80.1 S 80° E 90.5	1 2 6 7	
1994 7 Nov.	MIDWESTERN-CONSULTING Job # 94285			S. 1/2 of Section 36	No Indication	No witnesses			

APPROVED  
DATE 10/30/95  
CO. REP. KA