

SURVEY & REMONUMENTATION

MAY 09 1996

COMMISSION

LAND CORNER RECORDATION CERTIFICATE
Filing Requirement of Act 74, Mich. P.A. 1970

For corners in

WASHTENAW
(County)

Located In:

Corner Code #

- | | | |
|------------------------------------|----------------------------------|------------|
| 1. Public Land Survey | T <u>1</u> S <u>6</u> R <u>E</u> | <u>L-9</u> |
| | T _____ R _____ | _____ |
| | T _____ R _____ | _____ |
| | T _____ R _____ | _____ |
| 2. Property Controlling in Section | S _____ T _____ R _____ | _____ |
| | S _____ T _____ R _____ | _____ |
| 3. Miscellaneous Property in Sec. | S _____ T _____ R _____ | _____ |
| | S _____ T _____ R _____ | _____ |
4. Lot No. _____, Recorded Plat _____
5. Private Claims _____

Liber 00001 Page 0407K

- Copy -

Register of Deeds Stamp & File Number

I, I. JOHN JEKABSON, in a field survey on 1 August, 1995, do hereby certify that under requirements of P.A. 74, Michigan P.A. of 1970, the corner points mentioned in lines 1 and 2 above were in conformance with regulations and rules therefore as required in the current manual of survey instructions of the United States Department of the Interior, Bureau of Land Management or by a decree of a Court of Law and/or that the corner points mentioned in lines 3, 4 and 5 above were in conformance with the rules of the Michigan Board of Land Surveyors or by a Decree of a Court of Law; established, re-established, monumented, re-monumented, recovered, found as expressed below:

	A	B	C	D	E	F	G	H	I	J	K	L	M
2	6	5	4	3	2	1							
3													
4	7	8	9	10	11	12							
5													
6	18	17	16	15	14	13							
7													
8	19	20	21	22	23	24							
9													
10	30	29	28	27	26	25							
11													
12	31	32	33	34	35	36							
13													

NOTE: Not more than 4 corners, all in the same town and range, may be recorded on this certificate.

A. Description of original monument and accessories and/or subsequent restoration:
 1819 G.L.O. - SET POST
 T. WAMPLER

WASHTENAW ENG. CO. Found Iron Pipe
 NORMAN N. FAHRNER #17620
 Job # 4468

SEE BACK OF THIS SHEET (NEXT PAGE) FOR CONTINUATION OF SECTION "A"


B. Description of corner evidence found and/or method applied in restoring or reestablishing corner:

FOUND 1"X18" IRON PIPE W/R&J CAP
 REMOVED AND DID NOT FIND ANYTHING ELSE.
 USING 8 WITNESSES FROM SECTION "A"

RECORDERED
 WASHTENAW COUNTY, MI
 MAR 29 1 29 PM '96
 PAGE 29
 COUNTY CLERK/REGISTRAR
- COPY -

C. Description of monument for corner and accessories established to perpetuate locating the position of the corner:

SET 1"X24" IRON PIPE W/REMON.	PK & RT in NW sd 12" Sugar Maple	N 55° E	9.48	6
CAP 4" ABOVE GROUND.	Nail in W sd 5" Sugar Maple	S 25° E	6.08	7
	PK & RT in W sd 14" Ash	North	9.83	8
	PK & RT in E sd 11" Cherry	N 45° W	10.63	9
	PK & RT in N sd 12" Basswood	S 75° W	10.63	10
	Nail in NW sd 16" Red Oak	S 30° W	61.82	11
	Nail in SE sd 27" Sugar Maple	S 55° W	76.40	12
	Nail in SE sd 32" Sugar Maple	S 70° W	91.71	13

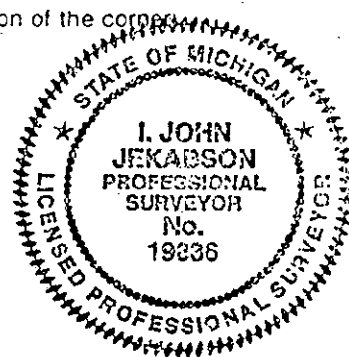

I conclude that after careful study of the record documentation and field observations, that this corner is accepted as the best available evidence of the position of the original corner.

Signed by I. John Jekabson

Date 1 DECEMBER, 1995

Surveyor's Michigan License No. 19236

CONTINUATION OF SECTION "A" 1995 WASHTENAW COUNTY REMONUMENTATION PROGRAM

History compiled by:
 I. John Jekabson P.S. # 19836
 Roskelly, Jekabson & Assoc. P.C.

NORTHFIELD TOWNSHIP TOWN 2 SOUTH, RANGE 3 EAST
 L - 9 (SOUTH 1/4 COR. SEC. 24 & NORTH 1/4 COR. SEC. 25)

DATE	COMPANY SURVEYOR & JOB #	P.S. #	P.A. 74 L.C.R.C.	LOCATION OF SURVEY	MONUMENT DESCRIPTION	WITNESSES	BEARING & DISTANCE	ID #	COMMENT
1973 15 May	WASHTENAW ENG. CO. NORMAN N. FAHRNER Job # 10046	#17620		N.W. 1/4 of section 25	Found 2" Iron Pipe	8" Hickory 10" Hickory 8" Cherry 6" Cherry 6" Hickory	North 18.3 N 20° W 9.4 N 07° W 17.7 N 50° W 13.7 S 05° W 18.0	1 2 3 4 5	These witnesses appear to be for different section corner. -- I.J.J.
1973 17 May	WASHTENAW ENG. CO. JOHN F. OLIVER	# 19840	Liber 3, Page 11		Found 2" Iron Pipe	Same as 1973, 17 May			
1978 13 Sept.	LAND S.E.A. CORP. GEORGE E. KATTOUAH SURVEY # G-72307-7	# 14095		S.E. 1/4 of Section 24	Fd. Iron	No Witnesses			
1989 14 Dec.	WASHTENAW ENG. CO. H. LAWRENCE O'DONNELL Job # 22776	# 28419		N.E. 1/4 of Section 25 & S.E. 1/4 of Section 24	Found 1" Iron Pipe	10" Maple 4" Maple 12" Ash 10" Cherry 8" Elm	N 50° E 9.51 S 10° E 6.08 North 9.83 N 45° W 10.64 S 85° W 10.00	6 7 8 9 10	
1991 7 Nov.	ROSKELLY, JEKABSON & ASSOC., P.C. I. JOHN JEKABSON Job # 91-10-68	# 19836		N.W. 1/4 of section 25	Found 1" Iron Pipe	Nail in 13" Ash Nail in 10" Sugar Maple Nail in 4" Sugar Maple Nail in 10" Basswood Nail in 15" Red Oak Nail in 27" Sugar Maple Nail in 32" Sugar Maple	North 9.83 N 55° E 9.48 S 25° E 6.08 S 75° W 10.03 S 30° W 61.82 S 55° W 76.40 S 70° W 91.71	8 6 7 10.7 11 12 13	
1991 11 Dec.	ROSKELLY, JEKABSON & ASSOC. P.C. I. JOHN JEKABSON	# 19836	Liber 7, Page 298		Found 1" Iron Pipe	Nail in 13" Ash Nail in 10" Sugar Maple Nail in 4" Sugar Maple Nail in 10" Basswood Nail in 15" Red Oak Nail in 27" Sugar Maple Nail in 32" Sugar Maple Nail in 11" Cherry	North 9.83 N 55° E 9.48 S 25° E 6.08 S 75° W 10.03 S 30° W 61.82 S 55° W 76.40 S 70° W 91.71 N 45° W 10.63	8 6 7 10.7 11 12 13 9	

APPROVED
 DATE 10/30/95
 CO. REP. Ky