

**SURVEY & REMONUMENTATION**

MAY 09 1996

*-copy-*

**COMMISSION**

**LAND CORNER RECORDATION CERTIFICATE**  
Filing Requirement of Act 74, Mich. P.A. 1970

For corners in

**WASHTENAW**  
(County)

Located In:

Corner Code =#

1. Public Land Survey	T	1 S	R	6 E	L-13
	T		R		
	T		R		
	T		R		
2. Property Controlling in Section	S		T	R	
	S		T	R	
3. Miscellaneous Property in Sec.	S		T	R	
	S		T	R	

REGISTERED  
 WASHTENAW COUNTY, MI  
 MAR 29 1 29 PM '96  
 COUNTY CLERK REGISTERED  
 -copy-  
 Register of Deeds Stamp & File Number

4. Lot No. \_\_\_\_\_, Recorded Plat \_\_\_\_\_  
 5. Private Claims \_\_\_\_\_

I, **JOHN JEKABSON**, in a field survey on **7 November**, 19 **95**, do hereby certify that under requirements of P.A. 74, Michigan P.A. of 1970, the corner points mentioned in lines 1 and 2 above were in conformance with regulations and rules therefore as required in the current manual of survey instructions of the United States Department of the Interior, Bureau of Land Management or by a decree of a Court of Law and/or that the corner points mentioned in lines 3, 4 and 5 above were in conformance with the rules of the Michigan Board of Land Surveyors or by a Decree of a Court of Law; established, re-established, monumented, re-monumented, recovered, found as expressed below:

A	B	C	D	E	F	G	H	I	J	K	L	M
2	5	5	4	3	2							
3												
4	7	8	9	10	11	12						
5												
6	18	17	16	15	14	13						
7												
8	19	20	21	22	23	24						
9												
10	30	29	28	27	26	25						
11												
12	31	32	33	34	35	36						
13												

**NOTE: Not more than 4 corners, all in the same town and range, may be recorded on this certificate.**

A. Description of original monument and accessories and/or subsequent restoration:  
 1819 G.L.O. - SET POST Red Oak, 12" N 80° E 18 Lks  
 T. WAMPLER White Oak, 15" S 38° W 15 Lks

Date Unknown WASHTENAW  
 COUNTY ROAD COMMISSION  
 GRID BOOK - H.H. ATWELL

Twin Elm, 14"	North	66.5	1
Hickory, 10"	N 45° W ?	44.6	2
B. Walnut, 6"	N 60° W ?	93.4	3
Elm, 10"	N 70° E	155.2	4
2 R. of W. Pipes			5


SEE BACK OF THIS SHEET (NEXT PAGE) FOR COMPLETE SECTION "A"

B. Description of corner evidence found and/or method applied in restoring or reestablishing corner:

FOUND 5/8" STEEL BAR (FOUND NOTHING BELOW IT)  
 USING 4 WITNESSES FROM SECTION "A"

C. Description of monument for corner and accessories established to perpetuate locating the position of the corner:

Found 5/8" Steel Bar (Found Nothing Below It)	PK & RT in W sd Utility Pole	N 20° W	57.07	9
	PK & RT in S sd 12" Cottonwood	N 80° E	46.46	12
SET 1/2"x24" IRON PIPE W/REMON CAP OVER THE STEEL BAR.	PK & RT in NE sd 30" Oak	S 50° E	64.90	8
	C/L Dead 12" Cherry	South	29.7	7
	PK & RT in NW sd 20" Elm	S 50° W	48.90	13
	4' S/N Edge/Gravel			10

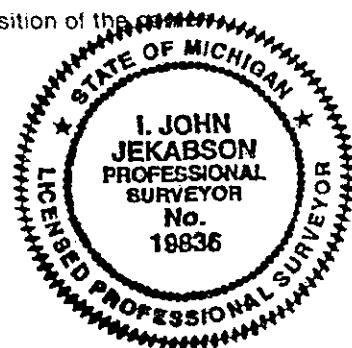

I conclude that after careful study of the record documentation and field observations, that this corner is accepted as the best available evidence of the position of the original corner.

Signed by I. John Jekabson Date 1 DECEMBER, 1995  
 Surveyor's Michigan License No. 19836

Copy -

COMPLETE SECTION "A" 1995 WASHTENAW COUNTY REMONUMENTATION PROGRAM

History compiled by:  
I. John Jekabson P.S. # 19836  
Roskelly, Jekabson & Assoc. P.C.

NORTHFIELD TOWNSHIP TOWN 2 SOUTH, RANGE 3 EAST  
L-13 (SOUTH 1/4 CORNER OF SECTION 36)

DATE	SURVEYOR & JOB #	P.S. #	P.A. 74 L.C.R.C.	COMPANY	LOCATION OF SURVEY	MONUMENT DESCRIPTION	WITNESSES	BEARING & DISTANCE	ID #	COMMENT
1819	G.L.O. T. WAMPLER					Set post	Red Oak, 12" White Oak, 15"	N 80° E 18 Lks S 38° W 15 Lks		
Unknown	WASHTENAW COUNTY ROAD COMMISSION GRID BOOK H.H. ATWELL					Iron Pipe	Twin Elm, 14" Hickory, 10" B. Walnut, 6" Elm, 10" 2 R. of W. Pipes	North 66.5 N 45° W ? 44.6 N 60° W ? 93.4 N 70° E 155.2	1 2 3 4 5	
1959 24 July	ATWELL-HICKS, INC. Job # 7478				S.E. 1/4 Section 36	No indication	No Witnesses			
1961 10 Nov.	DETROIT EDISON CO. J. SIERGIEJ Drawing # SMS-894-2				LARK CORRIDOR	Found 1" Iron	No Witnesses			
1987 15 May	WASHTENAW ENG. CO. NORMAN N. FAHRNER Job # 21326	#17620			S.W. 1/4 of Section 36	Found 1 1/2" Iron Pipe	10" Dead Hickory 12" Ash Stump 12" Cherry to nail 12" Oak	N 45° W 44.6 N 24° W 26.4 S 02° E 29.7 S 65° E 65.5	2 6 7 8	
1988 19 June	MIDWESTERN-CONSULTING Notes					Found 1" Iron Pipe	12" Cherry 16" Oak U.P. 4' S/N Edge/Gravel N 1/4 Cor Sec. 1 Ann Arbor Twp.	S. 29.7 S 50° E 64.13 N 20° W 57.57 West 262.05	7 8 9 10 11	
1989 1 Nov.	MIDWESTERN-CONSULTING ALLEN R. RENTSCHLER Job # 89291	# 15411			S.W. 1/4 of Section 36	No indication	No Witnesses			
1994 7 Nov.	MIDWESTERN-CONSULTING Job # 94285				S. 1/2 of Section 36	No Indication	No witnesses			
1995 Summer	AYRES, LEWIS, NORRIS, & MAY, INC. PAUL V. SCHWIMMER	# 24618			S. 1/2 of Section 36	Set 5/8" Steel Bar	No witnesses			

Reset with 5/8" Steel Bar as per MIDWESTERN-CONSULTING Job # 94285

APPROVED  
DATE 11/13/19  
CO. REP. KX