

SURVEY & REMONUMENTATION

MAY 09 1996

COMMISSION

LAND CORNER RECORDATION CERTIFICATE
Filing Requirement of Act 74, Mich. P.A. 1970

For corners in

WASHTENAW
(County)

Located In:

Corner Code #

1. Public Land Survey	T	1 S	R	6 E	M-9
	T		R		
	T		R		
	T		R		
2. Property Controlling in Section	S		T		R
	S		T		R
3. Miscellaneous Property in Sec.	S		T		R
	S		T		R

Liber 00001 Page 0413 R1

- Copy -

Register of Deeds Stamp & File Number

4. Lot No. _____, Recorded Plat _____
5. Private Claims _____

	A	B	C	D	E	F	G	H	I	J	K	L	M
2	6	5	4	3	2	1							
3													
4	7	8	9	10	11	12							
5													
6	18	17	16	15	14	13							
7													
8	19	20	21	22	23	24							
9													
10	30	29	28	27	26	25							
11													
12	31	32	33	34	35	36							
13													

I, JOHN JEKABSON, in a field survey on 7 November, 1995, do hereby certify that under requirements of P.A. 74, Michigan P.A. of 1970, the corner points mentioned in lines 1 and 2 above were in conformance with regulations and rules therefore as required in the current manual of survey instructions of the United States Department of the Interior, Bureau of Land Management or by a decree of a Court of Law and/or that the corner points mentioned in lines 3, 4 and 5 above were in conformance with the rules of the Michigan Board of Land Surveyors or by a Decree of a Court of Law; established, re-established, monumented, re-monumented, recovered, found as expressed below:

NOTE: Not more than 4 corners, all in the same town and range, may be recorded on this certificate.

A. Description of original monument and accessories and/or subsequent restoration:

1819 G.L.O. - SET POST	Ash, 20"	S 05° W 50 Lks			
T. WAMPLER	Do, 12"	S 60° E 20 Lks			
1936 26 June WASHTENAW COUNTY ROAD COMMISSION W.J. ARMSTRONG #2444	Found tile and stones.	Reset 1 1/2" x 36" Iron Pipe with a 4" tile over it and surrounded with bricks and stones.	White Oak, 18"	N 39° E 39.3	1
		This post is common to the Salem Twp. Corner (see Salem Twp. Grid Book)	White Oak, 4"	S 82° E 52.7	2
			Elm, 5"	S 27° E 44.8	3
			Elm, 4"	N 15° W 102.9	4
			2 R. of W. Pipes		

SEE BACK OF THIS SHEET (NEXT PAGE) FOR COMPLETE SECTION "A"


B. Description of corner evidence found and/or method applied in restoring or reestablishing corner:

FOUND 1 1/2" X 30" IRON PIPE SLIGHTLY BENT AT THE TOP, 3" BELOW GRAVEL SURFACE. FOUND BRICK AT 15" DEPTH.
USING 4 WITNESSES FROM SECTION "A"

RECORDED
 WASHTENAW COUNTY, MI
 MAR 29 1 29 PM '96
 JERRY A. JAMES
 COUNTY CLERK/REGISTER
 - COPY -

C. Description of monument for corner and accessories established to perpetuate locating the position of the corner:

Found 1 1/2" x 30" Iron pipe slightly bent at the top, 3" below gravel surface. Found brick at 15" depth.	PK & RT in NW sd 34" White Oak	N 40° E 39.06	1
Witnesses at 3.00 ft. Pulled out the (Armstrong) pipe and cut off the top 2" (flared & corroded).	PK & RT in N sd 28" White Oak	East 52.70	2
RESET THE 1 1/2" X 28" I.P. WITH A 1" X 24" I.P. W/REMON CAP IN IT, AT 6" BELOW GRAVEL SURFACE.	PK & RT in NE sd 14" Hickory	N 70° W 33.76	5
	PK & RT in SW sd 14" Ash	S 50° E 42.91	6
	Nail in NE sd 22" Hickory	N 65° W 37.69	8

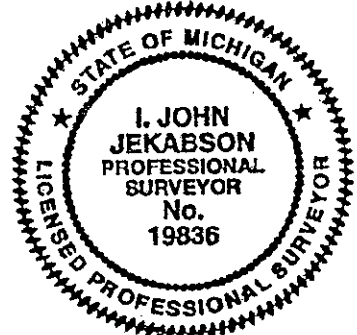

I conclude that after careful study of the record documentation and field observations, that this corner is a careful and faithful perpetuation of the position of the original corner.

Signed by I. John Jekabson

Date 1 DECEMBER, 1995

Surveyor's Michigan License No. 19836

1388 0414 Km

COMPLETE SECTION "A" - Copy -

1995 WASHTENAW COUNTY REMONUMENTATION PROGRAM

NORTHFIELD TOWNSHIP TOWN 2 SOUTH, RANGE 3 EAST
 M-9 (S.E. CORNER OF SEC. 24 & N.E. CORNER OF SEC. 25)

History compiled by:

I. John Jekabson P.S. # 19836
 Roskelly, Jekabson & Assoc. P.C.

DATE	COMPANY SURVEYOR & JOB #	P.S. #	P.A. 74 L.C.R.C.	LOCATION OF SURVEY	MONUMENT DESCRIPTION	WITNESSES	BEARING & DISTANCE	ID #	COMMENT
1819	G.L.O. T. WAMPLER				Set post	Ash, 20" Do, 12"	S 05° W 50 Lks S 60° E 20 Lks		
1935	WASHTENAW COUNTY ROAD COMMISSION W.J. ARMSTRONG	#2444			Set 1 1/2" x 36" Iron Pipe with a 4" tile over it and surrounded with bricks and stones.	White Oak, 18" White Oak, 4" Elm, 5" Elm, 4" 2 R. of W. Pipes	N 39° E 39.3 S 82° E 52.7 S 27° E 44.8 N 15° W 102.9	1 2 3 4	Found tile and stones. Reset 1 1/2" x 36" Iron Pipe with a 4" tile over it and surrounded with bricks and stones. This post is common to the Salem Twp. Corner (see Salem Twp. Grid Book)
1978	LAND S.E.A. CORP. GEORGE E. KATTIOUAH SURVEY # G-72307-7	# 14095		S.E. 1/4 of Section 24	Fd. Iron	No Witnesses			
1988	LAND SURVEYING CONSULTANTS R. TIMOTHY TIETSEMA Job # 22487-157E19	# 20712		S.W. 1/4 of Section 19 Salem Twp.	Found 1 1/2" Iron Pipe	13" Birch 36" W. Oak 12" Birch	N 70° W 33.76 N 35° E 39.00 S 60° E 42.91	5 1 6	
1989	WASHTENAW ENG. CO. H. LAWRENCE O'DONNELL Job # 22776	# 28419		N.E. 1/4 of Section 25 & S.E. 1/4 of Section 24	Fd. Iron	20" Hickory 10" Ash 24" Oak 12" Elm 20" Hickory	East 52.69 S 35° E 43.00 N 40° E 39.09 N 70° W 33.70 N 65° W 37.69	22 67 1 57 7	
1991	WASHTENAW ENG. CO. NORMAN N. FAHRNER Job # 23581	#17620		N.W. 1/4 of Section 30 Salem Twp.	Found Iron Pipe	Same as 1989, 14 December			
1991	WASHTENAW ENG. CO. NORMAN N. FAHRNER Job # 23600	#17620		N.W. 1/4 of Section 30 Salem Twp.	Found Iron Pipe	Same as 1989, 14 December			
1992	WASHTENAW ENG. CO. T.L. SUTHERLAND Job # 23959	#24620		S.W. 1/4 of Section 19 Salem Twp.	Found Iron Pipe	Same as 1989, 14 December			

APPROVED DATE 11/13/95
 CO. REP. *[Signature]*