

MAY 09 1996

COMMISSION

LAND CORNER RECORDATION CERTIFICATE
Filing Requirement of Act 74, Mich. P.A. 1970

For corners in

WASHTENAW
(County)

Located In:

Corner Code #

1. Public Land Survey

T 1 S R 6 E
T 1 S R 7 E
T 2 S R 6 E
T 2 S R 7 E

M-13
A-13
M-1
A-1

2. Property Controlling in Section
3. Miscellaneous Property in Sec.

S T R
S T R
S T R
S T R

REGISTERED
WASHTENAW COUNTY, MICH.
MAR 29 1 30 PM '96
Register of Deeds Stamp & File Number

4. Lot No. , Recorded Plat
5. Private Claims

Grid table with columns A-K and rows 2-13

I, JOHN JEKABSON, in a field survey on 8 November, 1995, do hereby certify that under requirements of P.A. 74, Michigan P.A. of 1970, the corner points mentioned in lines 1 and 2 above were in conformance with regulations and rules hereof as required in the current manual of survey instructions of the United States Department of the Interior, Bureau of Land Management or by a decree of a Court of Law and/or that the corner points mentioned in lines 3, 4 and 5 above were in conformance with the rules of the Michigan Board of Land Surveyors or by a Decree of a Court of Law; established, re-established, monumented, re-monumented, recovered, found as expressed below:

NOTE: Not more than 4 corners, all in the same town and range, may be recorded on this certificate.

A. Description of original monument and accessories and/or subsequent restoration:

1819 G.L.O. - SET POST Red Oak, 15" S 04° W 14Lks
T. WAMPLER Hickory, 12" N 22° E 24Lks

Date Unknown WASHTENAW COUNTY ROAD COMMISSION GRID BOOK - H.H. ATWELL

Iron Pipe

Maple, 6" S 60° W 64.5 1
S.E. Cor. House N.E. 168.75 2
N.E. Cor. House S.E. 164.5 3
Hickory, 6" N 62° W 54.1 4
Hickory, 10" N 22 1/2° W 68.9 5
Elm, 6" N 31 1/2° E 44.5 6


SEE BACK OF THIS SHEET (NEXT PAGE) FOR COMPLETE SECTION "A"

B. Description of corner evidence found and/or method applied in restoring or reestablishing corner:

FOUND 5/8" STEEL BAR IN MON BOX
USING 4 WITNESSES FROM SECTION "A"

C. Description of monument for corner and accessories established to perpetuate locating the position of the corner:

Found 5/8" Steel Bar in Mon Box PK & RT in SW sd Util. Pole N 46° W 60.32 14
SET 1"X18" IRON PIPE W/REMON. SW Cor. House N 44° E 145.34 11
CAP OVER THE STEEL BAR Nail in 24" Apple N 45° E 77.97 12
PK & RT in S sd Util. Pole N 80° E 142.46 15
PK & RT in SW sd Util. Pole S 60° E 122.46 16
Nail in NE sd 12" Walnut S 52° E 58.43 8
PK & RT in SE sd 17" Elm S 60° W 82.61 17

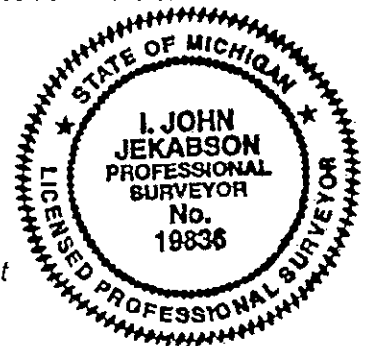

I conclude that after careful study of the record documentation and field observations, that this corner is accepted as the best available evidence of the position of the original corner.

Signed by [Signature] Date 1 DECEMBER, 1995

Surveyor's Michigan License No. 19836

- Copy -

1995 WASHTENAW COUNTY REMONUMENTATION PROGRAM

History compiled by:
I. John Jekabson P.S. # 19836
Roskelly, Jekabson & Assoc. P.C.

NORTHFIELD TOWNSHIP TOWN 2 SOUTH, RANGE 3 EAST
M-13 (SOUTHEAST CORNER OF SECTION 36)

DATE	COMPANY SURVEYOR & JOB #	P.S. #	P.A. 74 L.C.R.C.	LOCATION OF SURVEY	MONUMENT DESCRIPTION	WITNESSES	BEARING & DISTANCE	ID #	COMMENT
1819	G.L.O. T. WAMPLER				Set post	Red Oak, 15" Hickory, 12"	S 04° W 14Lks N 22° E 24Lks		
Unknown	WASHTENAW COUNTY ROAD COMMISSION Grid-Book H.H. ATWELL				Iron Pipe	Maple, 6" S.E. Cor. House N.E. Cor. House Hickory, 6" Hickory, 10" Elm, 6"	S 60° W 64.5 N.E. 168.75 S.E. 164.5 N 62° W 54.1 N 22½° W 68.9 N 31½° E 44.5	1 2 3 4 5 6	
1956	ATWELL - HICKS, INC. Job # 5231			S.E. ¼ OF SECTION 36	Found Iron	No Witnesses			
14 Jan. 1959	ATWELL-HICKS, INC. Job # 7478			S.E. 1/4 OF SECTION 36	No Indication	No Witnesses			
24 July 1961	DETROIT EDISON CO. J. SIERGIEJ Drawing # 5MS-894-2			LARK CORRIDOR	Found Iron	No Witnesses			
1966	WASHTENAW COUNTY ROAD COMMISSION Grid-Book R.B. (hand written)								
June 1972	WASHTENAW COUNTY ROAD COMMISSION Grid-Book R.B. (hand written)								
27 Sept. 1972	WASHTENAW ENG. CO. NORMAN N. FAHRNER #17620		Liber 2, Page 447	A-1 (NW corner Section 1) T.2S., R.7E.,	Found Monument Box	E. Pole to nail 9" Walnut to nail T. Pole to nail R/W Pipe SW Cor. House NE Cor. House 24" Apple 24" Apple	NE 145.7 SE 164.5 N 45° E 80.6 N 50° E 102.0	7 8 9 10 11 3 12 13	
1994	MIDWESTERN CONSULTING Job # 94285			S. 1/2 of Section 36	No Indication	No witnesses			

APPROVED
DATE 11/13/95
CO. REP. *[Signature]*