

**SURVEY &
REMONUMENTATION**

APPROVED
DATE 11-11-96
CO. REP. KA

MAY 05 1997

LAND CORNER RECORDATION CERTIFICATE
Filing Requirement of Act 74, Mich. P.A. 1970

RECORDED
WASHTENAW COUNTY, MI
FEB 18 9 14 AM '97
PEGGY M. HAINES
COUNTY CLERK/REGISTRAR

For corners in <u>Washtenaw</u> (County)	Located In:	Corner Code #
1. Public Land Survey	T <u>18</u> R <u>7E</u> T <u>5E</u>	<u>I-11</u>
2. Property Controlling in Section	S <u> </u> T <u> </u> R <u> </u>	<u> </u>
3. Miscellaneous Property in Sec.	S <u> </u> T <u> </u> R <u> </u>	<u> </u>

Liber **00001** Page **0628R1**

Register of Deeds Stamp & File Number

4. Lot No. _____, Recorded Plat _____
5. Private Claims _____

I, Thomas Sutherland, in a field survey on 10/24, 1996 do hereby state that under requirements of P.A. 74, Michigan P.A. of 1970, the corner points mentioned in lines 1 and 2 above were in conformance with regulations and rules therefore as required in the current manual of survey instructions of the United States Department of the Interior, Bureau of Land Management or by a decree of a Court of Law and/or that the corner points mentioned in lines 3, 4 and 5 above were in conformance with the rules of the Michigan Board of Land Surveyors or by a Decree of a Court of Law; established, re-established, monumented, recovered, found as expressed below:

A	B	C	D	E	F	G	H	I	J	K	L
1											
2	6		5		4		3		2		1
3											
4	7		8		9		10		11		12
5											
6	18		17		16		15		14		13
7											
8	19		20		21		22		23		24
9											
10	30		29		28		27		26		25
11											
12	31		32		33		34		35		36
13											

NOTE: Not more than 2 corners, all in the same town and range, may be recorded on this certificate.

A. Description of original monument and accessories and/or subsequent restoration:

- | | | | | | |
|---------|--------------------------|-------------|------|----|------------------------------------|
| 11/1815 | G.L.O.
JOSEPH WAMPLER | FIELD NOTES | NONE | 1) | 12" BEECH S72°W 7 LINKS |
| | | | | 2) | 4" BEECH S66°E 12 LINKS |
| 11/1844 | G.L.O.
HENRY PARKE | FIELD NOTES | NONE | 3) | 17 BEECH STUMP
N56°E 38 LINKS |
| | | | | 4) | 18" B. OAK N14 1/2°E
4.07 LINKS |

(SECTION A CONTINUED ON REVERSE SIDE)

B. Description of corner evidence found and/or method applied in restoring or reestablishing corner:

FROM OLD WITNESSES (*)

FOUND 1" X 12" IRON PIPE ON WESTERLY EDGE OF REMAINS OF N-S WIRE FENCE. RESET X 24" IRON PIPE W/REMON CAP.

C. Description of monument for corner and accessories established to perpetuate locating the position of the corner:


- | | | |
|---|-----|--|
| I conclude that after careful study of the record documentation and field observations, that this corner is accepted as the best available evidence of the position of the original corner. | *5) | N-S LANE EAST 12.0 TO CENTERLINE |
| | *6) | 14" APPLE S10°W 16.90 TO WCRP TAG ON WEST SIDE |
| | *8) | POWER POLE S85°E 31.00 TO WCRP TAG ON SOUTH SIDE |

1" X 24" Iron Pipe w/remon cap on Westerly edge of remains of N-S Wire Fence. (SECTION C CONTINUED ON REVERSE SIDE)

Signed by Thomas E. Sutherland
Surveyor's Michigan License No. 24620

Date NOVEMBER 13, 1996

COPY

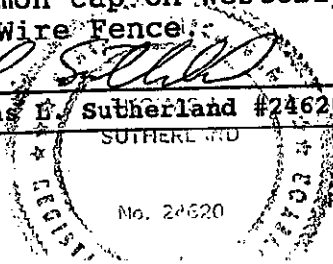

(CONTINUED FROM A ON FRONT)

1/28/73	MIDWESTERN CONSULTING AL RENTCHLER #15411	SURVEY 73103 & L.C.R.C. LIBER 3, PAGE 377	IRON PIPE	*5) *6) 7) *8)	LANE 3.5 EAST MSHD MARKER W/S 6" APPLE S10°W 16.92 SPK. W/S WEST GATE POST S10°E 5.94 SPK. N/S P. POLE S85°E 30.92
1/08/77	ROSKELLY, JEKABSON ROBERT ROSKELLY #18663	SURVEY - 77-10-112 SURVEY - 84-5-98	IRON PIPE	NONE	
3/24/86	ROSKELLY, JEKABSON JOHN JEKABSON #19836	SURVEY 86-3-59	1" IRON PIPE	*8) *9) 10) *11)	NAIL IN D.E. POLE S85°E 31.0 NAIL IN 40" COTTONWOOD S65°E 99.93 NAIL IN 18" TWIN CHERRY S20°W 61.60 NAIL IN 15" OAK S80°W 63.50
9/25/87	WASHTENAW ENGINEERING NORMAN FAHRNER #17620	SURVEY R-5714	1" IRON PIPE	*8) *6) 12) *13)	P. POLE S85°E 31.03 TO NAIL 8" APPLE S30°W 16.92 TO NAIL 6" TW. CHERRY N20°E 37.64 TO NAIL 10" MAPLE N50°W 59.27 TO NAIL
11/09/87	ATWELL-HICKS ROBERT MACOMBER #27453	SURVEY 503-197	IRON PIPE	*6) *8) 12) *9)	12" APPLE (NAIL) S10°W 16.92 POWER POLE (NAIL) S85°E 30.05 4" TWIN ASH (NAIL) N23°E 37.65 37" ASH (NAIL) S61°E 99.87

(CONTINUED FROM C ON FRONT)

*9) 40" COTTONWOOD
S65°E 99.87 TO WCRP
TAG ON NE SIDE

*11) 18" OAK S80°W 63.46 TO
WCRP TAG ON NORTH SIDE

*13) 14" MAPLE N50°W 59.03
TO WCRP TAG ON NE SIDE