

LAND CORNER RECORDATION CERTIFICATE
Filing Requirement of Act 74, Mich. P.A. 1970

For corners in
Washtenaw
(County)

Located in: Corner Code #

1. Public Land Survey T 1S R 7E I-13
T R
T R
T R

2. Property Controlling S T R
in Section S T R

3. Miscellaneous S T R
Property in Sec. S T R

RECORDED
 WASHTENAW COUNTY, MI
 APR 28 12 35 PM '97
 COUNTY CLERK'S REGISTER
 COPY

Register of Deeds Stamp & File Number
 Liber 00002 Page 0003RM

4. Lot No. _____, Recorded Plat _____
 5. Private Claims _____

I, Thomas Sutherland, in a field survey on 10/30/1996 do hereby state that under requirements of P.A. 74, Michigan P.A. of 1970, the corner points mentioned in lines 1 and 2 above were in conformance with regulations and rules therefore as required in the current manual of survey instructions of the United States Department of the Interior, Bureau of Land Management or by a decree of a Court of Law and/or that the corner points mentioned in lines 3, 4 and 5 above were in conformance with the rules of the Michigan Board of Land Surveyors or by a Decree of a Court of Law, established, re-established, monumented, recovered, found as expressed below:

NOTE: Not more than 2 corners, all in the same town and range, may be recorded on this certificate.

	A	B	C	D	E	F	G	H	I	J	K	L	M
1													
2	6		5		4		3		2		1		
3													
4	7		8		9		10		11		12		
5													
6	18		17		16		15		14		13		
7													
8	19		20		21		22		23		24		
9													
10	30		29		28		27		26		25		
11													
12	31		32		33		34		35		36		
13													

A. Description of original monument and accessories and/or subsequent restoration:
 1815 G.L.O. FIELD NOTES NONE NONE
 JOSEPH WAMPLER

(SECTION A CONTINUED ON REVERSE SIDE)

COPY APPROVED
 DATE 11/11/96
 CO. REP. Ky
 TO CORRECT LERR
 IN LIBER 1 PAGE 685

B. Description of corner evidence found and/or method applied in restoring or reestablishing corner:

FROM OLD WITNESSES (*)

Found an Iron Rod over a 1 1/2" Iron Pipe 5" below gravel surface. Found Bricks 12" below gravel surface. Set 3/4" Iron Pipe w/remon cap inside 1 1/2" pipe 6" below gravel surface.


APR 29 1997

C. Description of monument for corner and accessories established to perpetuate locating the position of the corner:

- I conclude that after careful study of the record documentation and field observations, that this corner is accepted as a careful and faithful perpetuation of the position of the original corner.
- *1) 3/4" IRON ROD (I-1, T2S, R7E) WEST 142.91
 - *5) 1 1/2" IRON PIPE (LEANING SOUTH) SOUTH 33.1+
 - *6) 1 1/2" IRON PIPE (LEANING SOUTH) NORTH 33.1+
- 3/4" Iron Pipe w/remon cap inside 1 1/2" pipe 6" below gravel surface.

(SECTION C CONTINUED ON REVERSE SIDE)

Signed by Thomas L. Sutherland Date NOVEMBER 12, 1996
 Surveyor's Michigan License No. THOMAS L. SUTHERLAND #24620

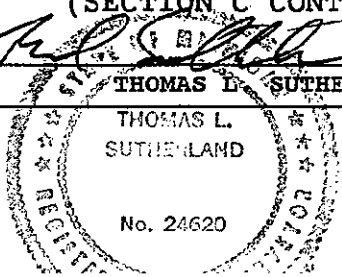

(CONTINUED FROM A. ON FRONT)

06/18/32	W.C.R.C. W.J. ARMSTRONG #2444	GRID BOOK	1 1/2" X 42" IRON PIPE	2)	2" APPLE N19°W 39.2
				3)	3" APPLE N49°W 65.0
				4)	3" ELM N10°E 21.8
				*5 & 6)	2 RIGHT-OF-WAY PIPES
09/25/72	ATWELL-HICKS HOWARD TAFT #12032	SURVEY 503-22	1" SOLID ROD	7)	24" WILLOW N45°E 36.0
				*8)	14" BASSWOOD N65°E 69.8
				9)	24" POPLAR S80°E 56.9
				10)	18" POPLAR S05°E 14.3
				11)	18" POPLAR S70°W 40.7
04/05/74	ATWELL-HICKS ROBERT JAGOW #6998	L.C.R.C. LIBER 3, PAGE 463	1" STEEL BAR	7)	30" WILLOW N43°E 35.2
				11)	16" POPLAR S60°W 40.8
				10)	18" POPLAR S03°E 13.9
				9)	16" POPLAR S62°E 57.0
				*1)	NE CORNER SEC. 3, SUPERIOR N89°55'W 143.14
06/26/75	ATWELL-HICKS	SURVEY 503-51	1" ROD	7)	24" WILLOW N45°E 36.0
07/25/78	ROBERT JAGOW	SURVEY 503-103			
08/23/78	#6998	SURVEY 503-104		*8)	14" BASSWOOD N65°E 69.8
				9)	24" POPLAR S80°E 56.9
				10)	18" POPLAR S5°E 14.3
				11)	18" POPLAR S70°W 20.7
08/25/83	WASHTENAW ENGINEERING G.F. DANN	FIELD NOTES	3/4" IRON ROD	*1)	NE CORNER SECTION 3, SUPERIOR WEST 143.05
09/01/83	WASHTENAW ENGINEERING NORMAN FAHRNER #17620	SURVEY R-4999		*1)	1/2" IRON PIPE (NE CORNER SECTION 3, T2S, R7E) W'LY 143.90
04/13/84	ROSKELLY, JEKABSON ROBERT ROSKELLY #18663	SURVEY 84-4-64		*1)	1/2" IRON PIPE (NE CORNER SECTION 3, T2S, R7E) W'LY 143.90
09/25/87	WASHTENAW ENGINEERING NORMAN FAHRNER #17620	SURVEY R-5714	3/4" IRON ROD	*12)	P. POLE N10°E 29.22 TO NAIL
				*13)	P. POLE N70°E 133.20 TO NAIL
				*14)	6" TRIP. BOX ELDER S25°E 30.57 TO NAIL

(CONTINUED FROM C. ON FRONT)

- *8) 4"-12" BASSWOOD CLUMP AROUND OLD STUMP N60°E 68.56 TO WCRP TAG ON SE SIDE 12" TRUNK
- *12) POWER POLE N10°E 29.20 TO WCRP TAG ON EAST SIDE
- *13) POWER POLE N75°E 133.20 TO WCRP TAG ON SOUTH SIDE
- *14) 8" TRIPLE BOX ELDER S25°E 30.61 TO WCRP TAG ON WEST SIDE CENTER TRUNK
- 15) 10" BOX ELDER N45°W 36.71 TO WCRP TAG ON SW SIDE
- 16) SE CORNER HOUSE N40°E 108.71 TO FOOTING