

**SURVEY &
REMONUMENTATION**

MAY - 1 1995

COMMISSION

COPY

**LAND CORNER RECORDATION CERTIFICATE
Filing Requirement of Act 74, Mich. P.A. 1970**

RECORDED
WASHTENAW COUNTY, MI

JAN 10 9 50 AM '95

PEGGY M. MAINES
COUNTY CLERK/REGISTER

For corners in

<u>Washtenaw</u> (County)	Located In:	Corner Code #
1. Public Land Survey	T <u>1S</u> R <u>7E</u>	<u>K-9</u>
	T _____ R _____	_____
	T _____ R _____	_____
	T _____ R _____	_____
2. Property Controlling in Section	S _____ T _____ R _____	_____
	S _____ T _____ R _____	_____
3. Miscellaneous Property in Sec.	S _____ T _____ R _____	_____
	S _____ T _____ R _____	_____

-COPY-

LIBER 1 PAGE 327 RM

-copy-

Register of Deeds Stamp & File Number

4. Lot No. _____, Recorded Plat _____
5. Private Claims _____

	A	B	C	D	E	F	G	H	I	J	K	L	M
2	6		5		4		3		2		1		
3													
4	7		8		9		10		11		12		
5													
6	16		17		16		15		14		13		
7													
8	19		20		21		22		23		24		
9													
10	30		29		28		27		26		25		
11													
12	31		32		33		34		35		36		
13													

Thomas L. Sutherland in a field survey on November 11, 19 94, do hereby certify that under requirements of P.A. 74, Michigan P.A. of 1970, the corner points mentioned in lines 1 and 2 above were in conformance with regulations and rules therefore as required in the current manual of survey instructions of the United States Department of the Interior, Bureau of Land Management or by a decree of a Court of Law and/or that the corner points mentioned in lines 3, 4 and 5 above were in conformance with the rules of the Michigan Board of Land Surveyors or by a Decree of a Court of Law; established, re-established, monumented, re-monumented, recovered, found as expressed below:

NOTE: Not more than 4 corners, all in the same town and range, may be recorded on this certificate.

A. Description of original monument and accessories and/or subsequent restoration:

(Washtenaw County Road Commission 1938)
1 1/2" x 38" Iron Pipe with Bricks
10" B. Cherry S87°E 60.8
12" Burr Oak S12°E 112.5
1 1/2" Spruce S56°W 65.4
12" B. Hickory N8°E 101.0

(Roskelly and Jekabson 1974)
Large Iron
PK Nail in 18" Cherry EAST 60.68
PK Nail in D.E. Pole S60°E 44.59
PK Nail in Utility Pole S60°W 75.00
PK Nail in 15" Twin Cherry N30°W 11.22

(Washtenaw Engineering Company 1987)
1 1/2" Iron Pipe
12" Maple N2°W 39.52 to PK
P. Pole S60°E 44.58 to PK
14" Spruce S56°W 65.4 SW corner Yanson Grave Marker N65°E 81.0
18" Twin Cherry N10°W 11.18 to Nail

B. Description of corner evidence found and/or method applied in restoring or reestablishing corner:

Found 1 1/2" Cast Iron Pipe with Bricks and Stones. Set Remonumentation Cap on existing Pipe and Re-witnessed.


C. Description of monument for corner and accessories established to perpetuate locating the position of the corner:

1 1/2" Iron Pipe with Aluminum Washtenaw County Remonumentation Cap
36" Burr Oak S12°E 112.50 to Nail W/W.C.R. Tag on W. Side
24" Spruce S56°W 65.19 to Nail W/W.C.R. Tag on N.W. Side
Power Pole S50°E 44.59 to Nail W/W.C.R. Tag on S.W. Side
Power Pole S65°W 75.01 to Nail W/W.C.R. Tag on NW Side
24" Twin Cherry N15°W 10.67 to Nail W/W.C.R. Tag on W. Side
14" Hickory N02°W 39.52 to Nail W/W.C.R. Tag on E. Side
S.W. Corner Yanson Grave Marker N65°E 80.92

I conclude that after a careful study of the record documentation and field observation, that this corner is accepted as the best available evidence of the position of the original corner.

Signed by Thomas L. Sutherland
Surveyor's Michigan License No. #24620

Date December 13, 1994

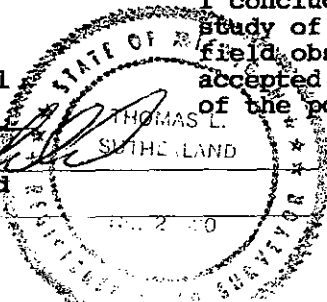

APPROVED

DATE 11/21/94

CO. REP. [Signature]