

**SURVEY &
REMONUMENTATION**

MAY - 1 1995

COMMISSION

COPY

RECORDED
WASHTENAW COUNTY, MI

JAN 10 9 50 AM '95

**LAND CORNER RECORDATION CERTIFICATE
Filing Requirement of Act 74, Mich. P.A. 1970**

PEGGY M. HAINES
COUNTY CLERK/REGISTER

-COPY-

For corners in

Washtenaw (County)	Located In:	Corner Code #
1. Public Land Survey	T <u>1S</u> R <u>7E</u>	<u>K-10</u>
	T _____ R _____	_____
	T _____ R _____	_____
	T _____ R _____	_____
2. Property Controlling in Section	S _____ T _____ R _____	_____
	S _____ T _____ R _____	_____
3. Miscellaneous Property in Sec.	S _____ T _____ R _____	_____
	S _____ T _____ R _____	_____

LIBER 1 PAGE 328 Rm

-Copy-

Register of Deeds Stamp & File Number

4. Lot No. _____, Recorded Plat _____
5. Private Claims _____

	A	B	C	D	E	F	G	H	I	J	K	L	M
2	6		5		4		3		2		1		
3													
4	7		8		9		10		11		12		
5													
6	18		17		16		15		14		13		
7													
8	19		20		21		22		23		24		
9													
10	30		29		28		27		26		25		
11													
12	31		32		33		34		35		36		
13													

Thomas L. Sutherland in a field survey on November 11, 19 94, do hereby certify that under requirements of P.A. 74, Michigan P.A. of 1970, the corner points mentioned in lines 1 and 2 above were in conformance with regulations and rules therefore as required in the current manual of survey instructions of the United States Department of the Interior, Bureau of Land Management or by a decree of a Court of Law and/or that the corner points mentioned in lines 3, 4 and 5 above were in conformance with the rules of the Michigan Board of Land Surveyors or by a Decree of a Court of Law; established, re-established, monumented, re-monumented, recovered, found as expressed below:

NOTE: Not more than 4 corners, all in the same town and range, may be recorded on this certificate.

- A. Description of original monument and accessories and/or subsequent restoration:
- | | | |
|------------------------------|-----------------------------------|-------------------------|
| (W.C.R.C., 1957) | (Roskelly and Jekabson 1978-1993) | (Atwell-Hicks 1987) |
| U.S.C. & G.S. BM #10-1 | 1978 R.R. Spike | Found 1/2" Iron Rod |
| EAST 22.25 | 1993 Pipe in Box | Power Pole (Nail w/tag) |
| 6" Walnut Southwesterly 53.7 | Northwest Corner Party | N28°W 68.85 |
| | Store S85°E 65.90 | 10" Ash S50°W 54.0 |
| (W.C.R.C. 1988) | D.E. Pole S30°E 72.02 | 1" Square Iron Bar |
| PA 74 L.C.R.C. | to Nail | EAST 23.06 |
| Liber 7, Page 196 | M.B.T. Pole S25°W | Power Pole (Nail) |
| | 100.60 to Nail | N63°W 75.89 |
| | M.B.T. Pole N60°W 75.90 to Nail | |
| | M.B.T. Pole N30°W 68.90 to Nail | |

B. Description of corner evidence found and/or method applied in restoring or reestablishing corner:

Found 3/4" Iron Pipe with R. Campbell plastic cap in monument box. Set aluminum Washtenaw County Remonumentation Cap on existing pipe over plastic cap.

APPROVED


DATE 12/9/94

CO. REP. H

C. Description of monument for corner and accessories established to perpetuate locating the position of the corner:

16" Walnut S55°W 54.13
to Nail W/W.C.R. Tag on NW side
NW corner Quonset Hut S85°E 65.80
to West edge roofing at ground
Power Pole S25°E 72.32 to Nail
W/W.C.R. Tag on SW Side
Telephone Pole S15°W 100.63 to Nail
Telephone Pole N25°W 68.98 to Nail
W/W.C.R. Tag on SW Side
1" Square Iron Bar EAST 23.03
Power Pole N63°W 75.89 to Nail
W/W.C.R. Tag on NE Side

I conclude that after careful study of the record documentation and field observations, that this corner is accepted as the best available evidence of the position of the original corner.

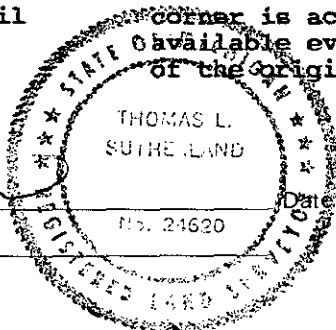

Signed by Thomas L. Sutherland
Surveyor's Michigan License No. 24620

Date December 13, 1994