

**SURVEY &
REMONUMENTATION**

MAY - 1 1995

COMMISSION

COPY

**LAND CORNER RECORDATION CERTIFICATE
Filing Requirement of Act 74, Mich. P.A. 1970**

RECORDED
WASHTENAW COUNTY, MI

JAN 10 9 50 AM '95

PEGGY M. HAINES
COUNTY CLERK/REGISTER

- COPY -

LIBER

1 PAGE 329 RM

- Copy -

Register of Deeds Stamp & File Number

For corners in

Washtenaw (County)	Located In:	Corner Code #
1. Public Land Survey	T <u>1S</u> R <u>7E</u>	<u>K-11</u>
	T _____ R _____	_____
	T _____ R _____	_____
	T _____ R _____	_____
2. Property Controlling in Section	S _____ T _____ R _____	_____
	S _____ T _____ R _____	_____
3. Miscellaneous Property in Sec.	S _____ T _____ R _____	_____
	S _____ T _____ R _____	_____

4. Lot No. _____, Recorded Plat _____
5. Private Claims _____

Thomas L. Sutherland in a field survey on November 11, 19 94, do hereby certify that under requirements of P.A. 74, Michigan P.A. of 1970, the corner points mentioned in lines 1 and 2 above were in conformance with regulations and rules therefore as required in the current manual of survey instructions of the United States Department of the Interior, Bureau of Land Management or by a decree of a Court of Law and/or that the corner points mentioned in lines 3, 4 and 5 above were in conformance with the rules of the Michigan Board of Land Surveyors or by a Decree of a Court of Law; established, re-established, monumented, re-monumented, recovered, found as expressed below:

NOTE: Not more than 4 corners, all in the same town and range, may be recorded on this certificate.

	A	B	C	D	E	F	G	H	I	J	K	L	M
2	6		5		4		3		2		1		
3													
4	7		8		9		10		11		12		
5													
6	18		17		16		15		14		13		
7													
8	19		20		21		22		23		24		
9													
10	30		29		28		27		26		25		
11													
12	31		32		33		34		35		36		
13													

A. Description of original monument and accessories and/or subsequent restoration:

Roskelly and Jekaboson 1986-1993)
Found Monument in Monument Box
 PK Nail Top Guard Rail
 N45°E 42.65
 PK Nail Top Guard Rail
 S60°E 36.80
 PK Nail Top Guard Rail
 S45°W 32.46
 PK Nail Top Guard Rail
 N45°W 34.35
 North Face Concrete Bridge
 SOUTH 318.90

B. Description of corner evidence found and/or method applied in restoring or reestablishing corner:

Found a metal M.S.H.D. Cap wired to a broken concrete monument with an iron rod in a monument box. The metal cap was slightly above grade. Removed cap, part of the iron rod and part of the concrete from the monument. Crushed concrete part of monument and re-set with a 3/4" iron pipe with Aluminum Washtenaw County Remonumentation Cap over the lower part of the existing iron rod inside the monument box.

P.K. Nails used for witnesses to guard posts were driven into spacer blocks between guard rail and posts. Re-witnesses to new nails in actual posts because spacer blocks were becoming loose.

C. Description of monument for corner and accessories established to perpetuate locating the position of the corner:


3/4" Iron Pipe with Aluminum Washtenaw County Remonumentation Cap in Monument Box
 Guard Rail Post N45°E 43.08
 to Nail W/W.C.R. Tag in Top
 Guard Rail Post S60°E 37.38
 to Nail W/W.C.R. Tag in Top
 Guard Rail Post S40°W 32.92
 to Nail W/W.C.R. Tag in Top
 Guard Rail Post N45°W 34.78
 to Nail W/W.C.R. Tag in top
 North Edge Concrete Bridge at Section Line SOUTH 319.02

East Edge of East Post to
 "Bridge May Be Icy"
 Sign N30°W 77.41

I conclude that after careful study of the record documentation and field observations, that this corner is accepted as the best available evidence of the position of the original corner.

Signed by Thomas L. Sutherland
 Surveyor's Michigan License No. 24620

Date December 13, 1994

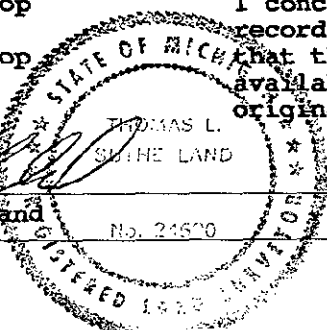

APPROVED

DATE 12/13/94

CO. REP. KA