

SURVEY & REMONUMENTATION

MAY - 1 1995

COPY

RECORDED WASHTENAW COUNTY, MI

JAN 10 9 52 AM '95

LAND CORNER RECORDATION CERTIFICATE Filing Requirement of Act 74, Mich. P.A. 1970

COMMISSION

For corners in

PEGGY M. HAINES COUNTY CLERK/REGISTERED

Table with columns: Washtenaw (County), Located In: (Township, Range, Section), Corner Code #. Includes entries for Public Land Survey, Property Controlling in Section, and Miscellaneous Property in Sec.

- COPY -

LIBER 1 PAGE 332 RM

- Copy -

Register of Deeds Stamp & File Number

- 4. Lot No. , Recorded Plat
5. Private Claims

Grid table with columns A-M and rows 2-13, containing numbers 1-36.

Thomas L. Sutherland in a field survey on November 11, 1994, do hereby certify that under requirements of P.A. 74, Michigan P.A. of 1970, the corner points mentioned in lines 1 and 2 above were in conformance with regulations and rules therefore as required in the current manual of survey instructions of the United States Department of the Interior, Bureau of Land Management or by a decree of a Court of Law and/or that the corner points mentioned in lines 3, 4 and 5 above were in conformance with the rules of the Michigan Board of Land Surveyors or by a Decree of a Court of Law; established, re-established, monumented, re-monumented, recovered, found as expressed below:

NOTE: Not more than 4 corners, all in the same town and range, may be recorded on this certificate.

A. Description of original monument and accessories and/or subsequent restoration:

(Washtenaw Engineering Company 1978)

(Roskelly Jekabson 1986)

47.81 feet EAST of N 1/4 Corner, Section 1, Superior Township 14" Maple S10°E 29.45 to Nail 12" Hickory S55°E 49.00 to Nail 8" Cherry N40°E 28.73 to Nail Power Pole S50°W 56.35 to Nail

PK Nail in 14" Hickory S60°E 49.02 PK Nail in 15" Basswood S20°E 29.46 PK Nail in D.E. Pole S60°W 56.36 N 1/4 Corner Section 1 - 2" Pipe WEST 47.80

B. Description of corner evidence found and/or method applied in restoring or reestablishing corner:

Found 1" Iron Pipe 12" below gravel surface. Raised to 6" below gravel surface with 3/4" Iron Pipe and Washtenaw County Remonumentation Cap and Re-witnessed.

APPROVED

DATE 12/5/94


CO. REP. KJ

C. Description of monument for corner and accessories established to perpetuate locating the position of the corner:

3/4" Iron Pipe with an Aluminum Washtenaw County Remonumentation Cap 1 1/2" Iron Pipe (N 1/4 Corner Section 1, T2S, R7E, WEST 47.78 24" Basswood S10°E 29.84 to Nail W/W.C.R. Tag on W. Side 15" Hickory S60°E 49.02 to Nail W/W.C.R. Tag on N.E. Side 14" Cherry N50°E 28.73 to Nail W/W.C.R. Tag on S.E. Side Power Pole N60°W 56.90 to Nail W/W.C.R. Tag on N.W. Side

I conclude that after careful study of the record documentation and field observation, that this corner is accepted as the best available evidence of the position of the original corner.

Signed by Thomas L. Sutherland Surveyor's Michigan License No. #24620

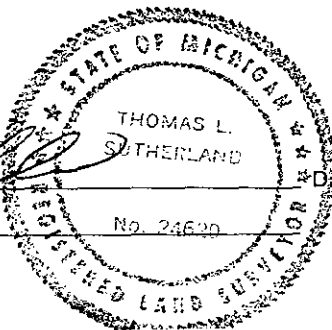

Date December 12, 1994