

**SURVEY &
REMONUMENTATION**

MAY - 1 1995

COPY

RECORDED
WASHTENAW COUNTY, MI

JAN 10 9 52 AM '95

LAND CORNER RECORDATION CERTIFICATE
Filing Requirement of Act 74, Mich. P.A. 1970

PEGGY M. HAINES
COUNTY CLERK/REGISTER

COMMISSION
For corners in

Washtenaw (County)	Located In:	Corner Code #
1. Public Land Survey	T <u>1S</u> R <u>7E</u>	<u>M-10</u>
	T _____ R _____	_____
	T _____ R _____	_____
	T _____ R _____	_____
2. Property Controlling in Section	S _____ T _____ R _____	_____
	S _____ T _____ R _____	_____
3. Miscellaneous Property in Sec.	S _____ T _____ R _____	_____
	S _____ T _____ R _____	_____

- COPY -

LIBER 1 PAGE 334 Rm

- COPY -

Register of Deeds Stamp & File Number

4. Lot No. _____, Recorded Plat _____
5. Private Claims _____

	A	B	C	D	E	F	G	H	I	J	K	L	M
2	6	5	4	3	2	1							
3													
4	7	8	9	10	11	12							
5													
6	18	17	16	15	14	13							
7													
8	19	20	21	22	23	24							
9													
10	30	29	28	27	26	25							
11													
12	31	32	33	34	35	36							
13													

Thomas L. Sutherland in a field survey on November 11, 19 94, do hereby certify that under requirements of P.A. 74, Michigan P.A. of 1970, the corner points mentioned in lines 1 and 2 above were in conformance with regulations and rules therefore as required in the current manual of survey instructions of the United States Department of the Interior, Bureau of Land Management or by a decree of a Court of Law and/or that the corner points mentioned in lines 3, 4 and 5 above were in conformance with the rules of the Michigan Board of Land Surveyors or by a Decree of a Court of Law; established, re-established, monumented, re-monumented, recovered, found as expressed below:

NOTE: Not more than 4 corners, all in the same town and range, may be recorded on this certificate.

A. Description of original monument and accessories and/or subsequent restoration:

(J.B. Davis)
Plough Coulter with Cast
Iron Axle Box
Stones and Bricks
7" Elm N80°E 15.15
15" Elm S70°W 40.05

(Michigan State Highway
Dept. 1968)
Found Plow Colter
in cast iron (2 1/2")
Axle Box 8" below
gravel of road (Napier)
4" Concrete Monument (W 1/4
Corner Section 30, T1S, R8E)
N03°W 22.20
SE Corner Section 25 SOUTH
2644.08

(Roskelly and Jekabson
1974 & 1979)
Iron with Ralph J.
Landini Cap
Concrete Monument N10°W
22.12
Nail in 12" Stump S60°E
15.85
SE Corner Section 25 SOUTH
2643.90
Nail in 12" Stump N60°W
65.48

B. Description of corner evidence found and/or method applied in restoring or reestablishing corner:

Found 1/2" Rod with
Landini Cap that
Matched detailed
relation to W 1/4 Cor.
Section 30, T1S, R8E,
as shown on M-14 Plans.
Re-set 1" x 24" Iron
Pipe with an Aluminum
Washtenaw County
Remonumentation Cap
and Re-witnessed.

APPROVED

DATE 11/21/94


CO. REP. HA

C. Description of monument for corner and accessories established to perpetuate locating the position of the corner:

1" Iron Pipe with Aluminum Washtenaw
County Remonumentation Cap
Conc. Monument (W 1/4 Corner
Section 30, T1S, R8E
N05°W 22.12
14" Willow N15°E 58.45 to Nail
W/W.C.R. Tag on W. Side
Power Pole N15°W 86.46 to Nail
W/W.C.R. Tag on E. Side
8" Willow S07°E 158.22 to Nail
W/W.C.R. Tag on W. Side
18" Oak WEST 109.62 to Nail
W/W.C.R. Tag on S. Side

I conclude that after careful study of
the record documentation and field
observation, that this corner is
accepted as the best available evidence
of the position of the original corner.

Signed by Thomas L. Sutherland
Surveyor's Michigan License No. 24620

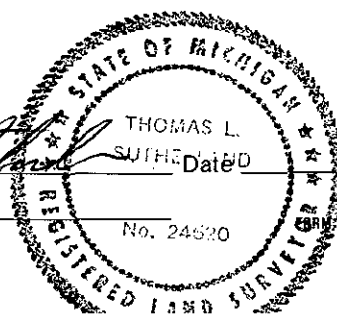

December 12, 1994