

**SURVEY &  
REMONUMENTATION**

MAY - 1 1995

**COMMISSION**

**COPY**

RECORDED  
WASHTENAW COUNTY, MI

Jan 10 9 53 AM '95

**LAND CORNER RECORDATION CERTIFICATE**  
Filing Requirement of Act 74, Mich. P.A. 1970

For corners in

<u>Washtenaw</u> <small>(County)</small>	Located In:	Corner Code #
1. Public Land Survey	T <u>1S</u> R <u>7E</u>	<u>M-12</u>
	T _____ R _____	_____
	T _____ R _____	_____
	T _____ R _____	_____
2. Property Controlling in Section	S _____ T _____ R _____	_____
	S _____ T _____ R _____	_____
3. Miscellaneous Property in Sec.	S _____ T _____ R _____	_____
	S _____ T _____ R _____	_____

PEGGY H. HAINES  
COUNTY CLERK/REGISTER

-COPY-

LIBER

1 PAGE 336 Rm

-Copy-

Register of Deeds Stamp & File Number

4. Lot No. \_\_\_\_\_, Recorded Plat \_\_\_\_\_  
5. Private Claims \_\_\_\_\_

	A	B	C	D	E	F	G	H	I	J	K	L	N
2	6		5		4		3		2		1		
3													
4	7		8		9		10		11		12		
5													
6	18		17		16		15		14		13		
7													
8	19		20		21		22		23		24		
9													
10	30		29		28		27		26		25		
11													
12	31		32		33		34		35		36		
13													

**Thomas L. Sutherland** in a field survey on November 11, 19 94, do hereby certify that under requirements of P.A. 74, Michigan P.A. of 1970, the corner points mentioned in lines 1 and 2 above were in conformance with regulations and rules therefore as required in the current manual of survey instructions of the United States Department of the Interior, Bureau of Land Management or by a decree of a Court of Law and/or that the corner points mentioned in lines 3, 4 and 5 above were in conformance with the rules of the Michigan Board of Land Surveyors or by a Decree of a Court of Law; established, re-established, monumented, re-monumented, recovered, found as expressed below:

**NOTE: Not more than 4 corners, all in the same town and range, may be recorded on this certificate.**

A. Description of original monument and accessories and/or subsequent restoration:

<b>(Armstrong 1936)</b> Found a cast iron sleigh shoe and stones set by J.B. Davis. Put a short piece of 3" pipe over sleigh shoe and put stone crockery and bricks around it.	<b>(Others)</b> Found concrete monument 8" Multi Hackberry N85°W 21.02 to Nail 8" Triple Hackberry N25°W 4.97 to Nail 8" Ash S45°E 28.55 to Nail SW face D.E. Tower N30°E 156.90 10" Cherry WEST 37.25
---	--

B. Description of corner evidence found and/or method applied in restoring or reestablishing corner:

Found a 4" Concrete monument from above witnesses  
12" Below gravel surface. Raised with 3/4" iron pipe with an aluminum Washtenaw County Remonumentation Cap to 6" below gravel surface and re-witnessed.


APPROVED  
DATE 12/6/94  
CO. REP. Kx

C. Description of monument for corner and accessories established to perpetuate locating the position of the corner:

3/4" Iron Pipe with an aluminum Washtenaw County Remonumentation cap over 4" Concrete Monument  
Multi. 12" Basswood N85°W 21.02 to Nail W/W.C.R. Tag on N. Side  
S.W. Face D.E. Tower N30°E 156.90  
Twin 14" Cherry West 37.25 to Nail W/W.C.R. Tag on S. Side  
Twin 6" Elm S20°W 74.91 to Nail W/W.C.R. Tag on E. Side  
14" Basswood S80°E 30.14 to Nail W/W.C.R. Tag on S. Side  
Iron Rod (W 1/4 Corner Section 30, T1S, R8E) NORTH 50.40

I conclude that after careful study of the record documentation and field observation, that this corner is accepted as the best available evidence of the position of the original corner.

Signed by Thomas L. Sutherland  
Surveyor's Michigan License No. #24520

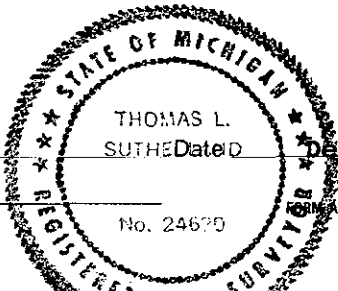

December 6, 1994