

**SURVEY &
REMONUMENTATION**

MAY - 1 1995

COMMISSION

COPY

RECORDED
WASHTENAW COUNTY, MI

JAN 10 9 53 AM '95

**LAND CORNER RECORDATION CERTIFICATE
Filing Requirement of Act 74, Mich. P.A. 1970**

PEGGY M. HAINES
COUNTY CLERK/REGISTER

For corners in

<u>Washtenaw</u> (County)	Located In:	Corner Code #
1. Public Land Survey	T <u>1S</u> R <u>7E</u>	<u>M-13</u>
	T _____ R _____	_____
	T _____ R _____	_____
	T _____ R _____	_____
2. Property Controlling in Section	S _____ T _____ R _____	_____
	S _____ T _____ R _____	_____
3. Miscellaneous Property in Sec.	S _____ T _____ R _____	_____
	S _____ T _____ R _____	_____

-COPY-

LIBER 1 PAGE 337 RM

-copy-

Register of Deeds Stamp & File Number

4. Lot No. _____, Recorded Plat _____
5. Private Claims _____

	A	B	C	D	E	F	G	H	I	J	K	L	M
2	6		5		4		3		2		1		
3													
4	7		8		9		10		11		12		
5													
6	18		17		16		15		14		13		
7													
8	19		20		21		22		23		24		
9													
10	30		29		28		27		26		25		
11													
12	31		32		33		34		35		36		
13													

Thomas L. Sutherland in a field survey on November 11, 19 94, do hereby certify that under requirements of P.A. 74, Michigan P.A. of 1970, the corner points mentioned in lines 1 and 2 above were in conformance with regulations and rules therefore as required in the current manual of survey instructions of the United States Department of the Interior, Bureau of Land Management or by a decree of a Court of Law and/or that the corner points mentioned in lines 3, 4 and 5 above were in conformance with the rules of the Michigan Board of Land Surveyors or by a Decree of a Court of Law; established, re-established, monumented, re-monumented, recovered, found as expressed below:

NOTE: Not more than 4 corners, all in the same town and range, may be recorded on this certificate.

A. Description of original monument and accessories and/or subsequent restoration:

(Roskelly and Jekabson)
Iron Bar in Box

Southeast Corner Section 36 is same as P.I. in Plymouth-Ann Arbor Road.	6" High Steel Fence Post S20°E 82.00 Road Name Sign N25°W 52.30 Nail in 8" Ash N60°W 102.05 Nail in 10" Ash N10°W 162.80
---	--

B. Description of corner evidence found and/or method applied in restoring or reestablishing corner:

Found 5/8" Iron Bar
in Monument Box (also
P.I. Plymouth-Ann Arbor
Road). Set Washtenaw
County Remonumentation
Cap over Bar and
Re-Witnessed.


APPROVED
DATE 11/21/94
CO. REP. [Signature]

C. Description of monument for corner and accessories established to perpetuate locating the position of the corner:

5/8" Bar in Monument Box with Aluminum
Washtenaw County Remonumentation Cap
6' High Steel Corner Fence
Post S20°E 81.91
Road Name Sign S30°W 52.30
10" Ash N60°W 102.05 to Nail
W/W.C.R. Tag in S. Side
12" Ash N10°W 162.80 to Nail
W/W.C.R. Tag in E. Side
Chiseled X on S.W. Side Water
Manhole Rim N25°E 61.57

I conclude that after careful study of the record documentation and field observation, that this corner is accepted as the best available evidence of the position of the original corner.

Signed by [Signature]
Thomas L. Sutherland
Surveyor's Michigan License No. #24620

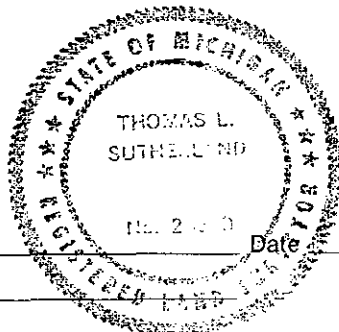

Date December 12, 1994