

MAY - 1 1995

COPY

JAN 10 9 49 AM '95

COMMISSION

LAND CORNER RECORDATION CERTIFICATE

Filing Requirement of Act 74, Mich. P.A. 1970

PEGGY M. HAINES COUNTY CLERK/REGISTER

For corners in

WASHTENAW (County)

Located In:

Corner Code #

- 1. Public Land Survey T 2 S R 3 E M-9
2. Property Controlling in Section S T R
3. Miscellaneous Property in Sec. S T R

- COPY -

LIBER 1 PAGE 318 Rm

- COPY -

Register of Deeds Stamp & File Number

- 4. Lot No. , Recorded Plat
5. Private Claims

Grid table with columns A-L and rows 2-13. Contains numbers 1-36 in a grid pattern.

I, JOHN JEKABSON, in a field survey on 19 October, 19 94, do hereby certify that under requirements of P.A. 74, Michigan P.A. of 1970, the corner points mentioned in lines 1 and 2 above were in conformance with regulations and rules therefore as required in the current manual of survey instructions of the United States Department of the Interior, Bureau of Land Management or by a decree of a Court of Law and/or that the corner points mentioned in lines 3, 4 and 5 above were in conformance with the rules of the Michigan Board of Land Surveyors or by a Decree of a Court of Law; established, re-established, monumented, re-monumented, recovered, found as expressed below:

NOTE: Not more than 4 corners, all in the same town and range, may be recorded on this certificate.

A. Description of original monument and accessories and/or subsequent restoration:

1824 G.L.O. - SET POST W. Oak, 9" N 60° E .26 JOHN M. MACK W. Oak, 10" S 76° W .92

1936 26 June WASHTENAW COUNTY ROAD COMMISSION W.J. ARMSTRONG #2444

Notes in Sylvan Twp. Field Book Page 12 Chaining South on the Range Line:

Beginning at the Place for the corner common to Secs. 24 & 25 179.0 Fence running East 210.5 Road East 242.0 Fence running East 2614.0 Fence running West 2780.0 Fence running East 5264.0 Corner Common to Secs. 25 & 36

SEE BACK OF THIS SHEET (NEXT PAGE) FOR COMPLETE SECTION "A"

B. Description of corner evidence found and/or method applied in restoring or reestablishing corner:

FOUND 1" X 18" IRON PIPE. USING 3 WITNESSES FROM SECTION "A"


APPROVED

DATE 12/15/94

CO. REP. [Signature]

C. Description of monument for corner and accessories established to perpetuate locating the position of the corner:

Found 1" x 18" Iron Pipe. PK & RT in S sd RR Tie Fence Cor. N 75° W 88.55 5 RESET WITH 1" X 24" IRON PIPE WITH ALUM. REMON CAP PK & RT in E sd RR Tie Fence Cor. N 30° W 24.93 47 PK & RT in W sd DE Pole N 10° E 25.95 3 PK & RT in SE sd 8" Black Walnut S 65° W 15.38 1 PK & RT in N sd 14" Elm S 88° W 29.20 6 center of gravel (Jerusalem Rd.) S 45° W 60' 7

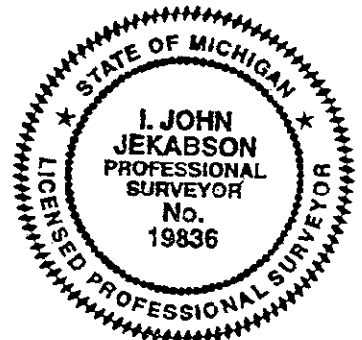

I conclude that after careful study of the record documentation and field observations, that this corner is accepted as the best available evidence of the position of the original corner.

Signed by [Signature] Date 13 December, 1994 Surveyor's Michigan License No. 19836

1994 WASHTENAW COUNTY REMONUMENTATION PROGRAM

SYLVAN TOWNSHIP TOWN 2 SOUTH, RANGE 3 EAST
 M-9 (S.E. CORNER OF SEC. 24 & N.E. CORNER OF SEC. 25)

History compiled by:
 I. John Jekabson P.S. # 19836
 Roskelly, Jekabson & Assoc. P.C.

DATE	COMPANY SURVEYOR JOB #	P.S. #	P.A. 74 L.C.R.C.	LOCATION OF SURVEY	MONUMENT DESCRIPTION	WITNESSES	BEARING & DISTANCE	ID #	COMMENT
1824	G.L.O. JOHN M. MACK				Set post	W. Oak, 9" W. Oak, 10"	N 60° E .26 S 76° W .92		
1936 26 June	WASHTENAW COUNTY ROAD COMMISSION W.J. ARMSTRONG	# 2444							Notes in Sylvan Twp. Field Book Page 12 Chaining South on the Range Line: Beginning at the Place for the corner common to Secs. 24 & 25 179.0 Fence running East 210.5 Road East 242.0 Fence running East
1984 17 Sept.	ROSKELLY, JEKABSON & ASSOC., P.C. I. JOHN JEKABSON Job # 76-5-297A	# 19836		PART OF S.E. 1/4 SEC. 25	Found Iron Pipe	No Witnesses			2614.0 Fence running West 2780.0 Fence running East 5264.0 Corner Common to Secs. 25 & 36 M 9 Sylvan to A-9 Lima (FIP) = 214.86
1985 1 November	WASHTENAW ENG. CO. NORMAN N. FAHRNER Job # 20842	#17620		PART OF SE 1/4 OF SECTION 24	Found 1 1/2" Iron Pipe	6" Walnut to nail 6" Elm to nail Power Pole to nail Corner Fence Post to nail	S 80° W 15.15 WEST 24.05 N 05° E 25.95 N 05° W ?	1 2 3 4	