

SURVEY &  
REMONUMENTATION

MAY - 1 1995

COMMISSION

LAND CORNER RECORDATION CERTIFICATE  
Filing Requirement of Act 74, Mich. P.A. 1970

For corners in  
Washtenaw  
County

Located in: Lima Twp Corner Code

1. Public Land Survey	T	2	S	R	4	E	1-9
	T			R			
	T			R			
	T			R			
2. Property Controlling in Section	S		T	R			
	S		T	R			
3. Miscellaneous Property in Sec.	S		T	R			
	S		T	R			

RECORDED  
 WASHTEENAW COUNTY, MI  
 SEP 21 11 21 AM '94  
 Page 1-9  
 REGGY H. HAINES  
 COUNTY CLERK/REGISTRAR  
 LIBER 1 PAGE 81RM  
 -COOV-  
 Register of Deeds Stamp and File Number

4. Lot No. \_\_\_\_\_, Recorded Plat \_\_\_\_\_  
 5. Private Claims \_\_\_\_\_

I, Michael S. Hoben in a field survey on Monday, January 11, 1993  
 do hereby certify that under requirements of P.A. 74, Michigan P.A. of 1970, the corner points mentioned in lines 1 and 2 above were in conformance with regulations and rules therefore as required in the current manual of survey instructions of the United States Department of the Interior, Bureau of Land Management, or by a decree of a Court of Law and/or that the corner points mentioned in lines 3, 4 and 5 above were in conformance with the rules of the Michigan Board of Land Surveyors or by a Decree of a Court of Law, established, re-established, monumented, re-monumented, recovered, found as expressed below.

NOTE: Not more than 4 corners, all in the same town and range, may be recorded on this certificate.

	A	B	C	D	E	F	G	H	I	J	K	L
2	6	5	4	3	2	1						
3												
4	7	8	9	10	11	12						
5												
6	18	17	16	15	14	13						
7												
8	19	20	21	22	23	24						
9												
10	30	29	28	27	26	25						
11												
12	31	32	33	34	35	36						
13												

A. Description of original monument and accessories and/or subsequent restorations:

Monday, January 01, 1816	Wampler			G.L.O.	Set post.
Witnesses:					
14" W.O. N 71 E 127 LINKS (83.82')					
22" W.O. N 65 E 122 LINKS (80.52')					
Wednesday, June 30, 1971	Norm Fahrner	17620	WE	L.1 P.6	Fd. 1" iron bar.
Witnesses:					
1 SPIKE IN E. SIDE 24" CHERRY N 49 W 17.5'					
2 SPIKE IN SOUTHWEST SIDE 30" OAK N 46 E 36.2'					
3 SPIKE IN WEST SIDE 36" OAK S 66 E 75.5'					
4 SPIKE IN N. SIDE 24" OAK S 21 W 51.8'					
Wednesday, July 28, 1976	Norm Fahrner	17620	WE	Certified	Fd. 1" iron bar.
Witnesses:					
1 SPIKE IN E. SIDE 24" CHERRY N 49 W 17.5'					
2 SPIKE IN SOUTHWEST SIDE 30" OAK N 46 E 36.2'					
3 SPIKE IN WEST SIDE 36" OAK S 66 E 75.5'					
4 SPIKE IN N. SIDE 24" OAK S 21 W 51.8'					
Friday, May 13, 1977	Norm Fahrner	17620	WE	Certified	Fd. 1" iron bar.
Witnesses:					
1 SPIKE IN E. SIDE 24" CHERRY N 49 W 17.5'					
2 SPIKE IN SOUTHWEST SIDE 30" OAK N 46 E 36.2'					
3 SPIKE IN WEST SIDE 36" OAK S 66 E 75.5'					
4 SPIKE IN N. SIDE 24" OAK S 21 W 51.8'					
Monday, March 10, 1980	R. A. Cambell	13028		L.6 P.9	
Witnesses:					
SET NAIL AT 40.84' N.W. SIDE					
SET NAIL AT 52.65' E. SIDE					
1 FD. 16" STUMP N 50 W 17.5' TO FACE					
2 FD NAIL IN FACE 38" OAK N 47 E 38.92					
4 FD. 23" OAK S 20 W 51.66' NAIL IN FACE					
Tuesday, January 08, 1985	T. Tietsema	20712	LSC	Certified	Fd. 1" iron bar.
Witnesses:					
2 24" OAK N 22 W 43.31 TO NAIL					
4 24" R. OAK S 23 W 52.68 TO NAIL					
5 36 W. OAK N 78 W 25.79' TO NAIL					

B. Description of corner evidence found and/or method applied in restoring or reestablishing corner:

Fd. 1" iron bar. Set WCR cap on iron bar.


C. Description of monument for corner and accessories established to perpetuate locating the position of the corner:

Monday, January 11, 1993	Orchard, Hiltz & McCliment, Inc.	21584	OHM	W. C. Remon
Witnesses:				
2 24" OAK N 22 W 43.23 TO PK NAIL WITH WCR TAG.				

- 5 42" W. OAK N 78 W 25.50' TO PK NAIL WITH WCR TAG.
- 6 12" CHERRY S 50 W 34.53' TO PK NAIL WITH WCR TAG.
- 7 6" TRI TREE S 46 E 61.84' TO PK NAIL WITH WCR TAG.

LIBER 1 PAGE 82R11  
-COPY-

We conclude that after careful study of the record documentation and field observations, that this corner is accepted as the best available evidence of the position of the original corner.

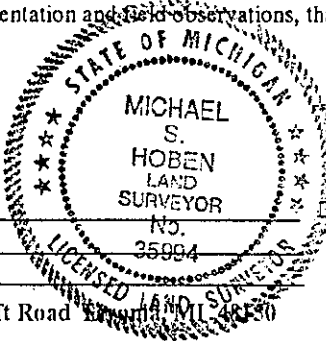

Signed by Michael S. Hoben Date Aug 2 1894  
 Drafted by Michael S. Hoben  
 Surveyor's Michigan License No. 35994  
 Orchard, Hiltz and McCliment, Inc. 34935 Schoolcraft Road

APPROVED  
 DATE 3-22-94  
 CO. REP. KZ