

**SURVEY & REMONUMENTATION**

MAY - 1 1995

**COMMISSION**

**LAND CORNER RECORDATION CERTIFICATE**  
Filing Requirement of Act 74, Mich. P.A. 1970

RECORDED  
 WASHTEENAW COUNTY, MI  
 SEP 21 11 22 AM '94  
 PER: H. HAINES  
 COUNTY CLERK/REGISTRAR  
 LIBER 1 PAGE 83Rm  
 -COPY-  
 Register of Deeds Stamp and File Number

For corners in  
Washtenaw  
County

Located in: Lima Twp Corner Code

- |                                       |              |              |         |
|---------------------------------------|--------------|--------------|---------|
| 1. Public Land Survey                 | T <u>2</u> S | R <u>4</u> E | I-10    |
|                                       | T _____      | R _____      | _____   |
|                                       | T _____      | R _____      | _____   |
|                                       | T _____      | R _____      | _____   |
| 2. Property Controlling in Section    | S _____      | T _____      | R _____ |
|                                       | S _____      | T _____      | R _____ |
| 3. Miscellaneous Property in Sec.     | S _____      | T _____      | R _____ |
|                                       | S _____      | T _____      | R _____ |
| 4. Lot No. _____, Recorded Plat _____ |              |              |         |
| 5. Private Claims _____               |              |              |         |

I, Michael S. Hoben in a field survey on Monday, November 01, 1993 do hereby certify that under requirements of P.A. 74, Michigan P.A. of 1970, the corner points mentioned in lines 1 and 2 above were in conformance with regulations and rules therefore as required in the current manual of survey instructions of the United States Department of the Interior, Bureau of Land Management. or by a decree of a Court of Law and/or that the corner points mentioned in lines 3, 4 and 5 above were in conformance with the rules of the Michigan Board of Land Surveyors or by a Decree of a Court of Law, established, re-established, monumented, re-monumented, recovered, found as expressed below.

NOTE: Not more than 4 corners, all in the same town and range, may be recorded on this certificate.

	A	B	C	D	E	F	G	H	I	J	K	L	M
2	6	5	4	3	2	1							
3													
4	7	8	9	10	11	12							
5													
6	18	17	16	15	14	13							
7													
8	19	20	21	22	23	24							
9													
10	30	29	28	27	26	25							
11													
12	31	32	33	34	35	36							
13													

A. Description of original monument and accessories and/or subsequent restorations:

Monday, April 11, 1938      W. J. Armstrong      2444      WCRC      Grid Book      Fd. old wood stake & set 1 1/2" X 40" iron pipe.

Witnesses:

- 14" B. CHERRY N. 40 E., 36.7'
- 10" BURR OAK N. 53 E., 16.3'
- 10" APPLE S. 43 W., 68.1'
- 10" ELM S. 49 W., 33.3'
- 18" HICKORY N. 54 W., 40.2'
- 30" W. OAK N. 43 W., 43.9'

Sunday, March 01, 1992      T. Tietsema      20712      LSC      Certificate of Survey      Fd. 1/2" iron pipe.

Witnesses:

- 22" BURR OAK N. 53 E., 16.3'
- 22" HICKORY N. 54 W., 40.2'
- 40" W. OAK N. 43 W., 43.9'
- 14" W. OAK S. 6 E., 55.4'

B. Description of corner evidence found and/or method applied in restoring or reestablishing corner:

Fd. 1/2" iron rod driven into a 1 1/2" iron pipe. Set WCR cap.


C. Description of monument for corner and accessories established to perpetuate locating the position of the corner:

Monday, November 01, 1993      Orchard, Hiltz & McCliment, Inc.      21584      OIIM      W. C. Remon

Witnesses:

- 20" BURR OAK N. 50 E., 15.83' TO PK NAIL WITH WCR TAG.
- 48" W. OAK N. 35 W., 43.28' TO PK NAIL WITH WCR TAG.
- 18" W. OAK S. 4 E., 55.16' TO PK NAIL WITH WCR TAG.
- D.E. POLE S. 78 W., 77.95' TO PK NAIL WITH WCR TAG.

We conclude that after careful study of the record documentation and field observations, the corner is accepted as a careful and faithful perpetuation of the position of the original corner.

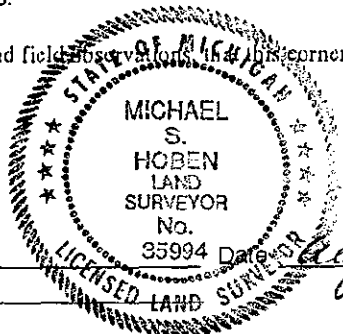

APPROVED  
DATE 4-19-94  
CO. REP. KA

Signed by Michael S. Hoben  
Drafted by Michael S. Hoben  
Surveyor's Michigan License No. 35994

Orchard, Hiltz and McCliment, Inc. 34935 Schoolcraft Road Livonia, MI 48150