

**SURVEY &
REMONUMENTATION**

MAY - 1 1995

COMMISSION

For corners in

Washtenaw

County

LAND CORNER RECORDATION CERTIFICATE

Filing Requirement of Act 74, Mich. P.A. 1970

Located in: Lima Twp Corner Code

- | | | | | | | | |
|---------------------------------------|---|----------|---|-------|----------|-------|-------|
| 1. Public Land Survey | T | <u>2</u> | S | R | <u>4</u> | E | I-11 |
| | T | _____ | R | _____ | _____ | _____ | _____ |
| | T | _____ | R | _____ | _____ | _____ | _____ |
| | T | _____ | R | _____ | _____ | _____ | _____ |
| 2. Property Controlling in Section | S | _____ | T | _____ | R | _____ | _____ |
| | S | _____ | T | _____ | R | _____ | _____ |
| 3. Miscellaneous Property in Sec. | S | _____ | T | _____ | R | _____ | _____ |
| | S | _____ | T | _____ | R | _____ | _____ |
| 4. Lot No. _____, Recorded Plat _____ | | | | | | | |
| 5. Private Claims _____ | | | | | | | |

RECORDED
 WASHTENAW COUNTY, MI
 SEP 21 11 22 AM '94
 PERCY M. HAINES
 COUNTY CLERK/REGISTRAR
 I-11 Page
 LIBER - COPY - 1 PAGE 84RM
 Register of Deeds Stamp and File Number

	A	B	C	D	E	F	G	H	I	J	K	L	M
2	6	5	4	3	2	1							
3													
4	7	8	9	10	11	12							
5													
6	18	17	16	15	14	13							
7													
8	19	20	21	22	23	24							
9													
10	30	29	28	27	26	25							
11													
12	31	32	33	34	35	36							
13													

I, Michael S. Hoben in a field survey on Monday, November 01, 1993 do hereby certify that under requirements of P.A. 74, Michigan P.A. of 1970, the corner points mentioned in lines 1 and 2 above were in conformance with regulations and rules therefore as required in the current manual of survey instructions of the United States Department of the Interior, Bureau of Land Management, or by a decree of a Court of Law and/or that the corner points mentioned in lines 3, 4 and 5 above were in conformance with the rules of the Michigan Board of Land Surveyors or by a Decree of a Court of Law, established, re-established, monumented, re-monumented, recovered, found as expressed below.

NOTE: Not more than 4 corners, all in the same town and range, may be recorded on this certificate.

A. Description of original monument and accessories and/or subsequent restorations:

- | | | | | | |
|--|-----------------|-------|------|-----------------------|--|
| Monday, January 01, 1816 | Wampler | | | G.L.O. | Set post. |
| Witnesses: | | | | | |
| 20" B. OAK N. 88 E., 30 LINKS (19.80') | | | | | |
| 16" B. OAK N. 18 E., 71 LINKS (46.86') | | | | | |
| Monday, December 15, 1941 | W. J. Armstrong | 2444 | WCRC | Grid Book | Fd. several marks of an old stake. Do not believe any of the stakes to be correct. Set an iron pipe. |
| Witnesses: | | | | | |
| 1 10" ELM S. 12 E., 25.7' | | | | | |
| 2 5" HICKORY S. 53.5 W., 20.7' | | | | | |
| 3 5" S.W. OAK S. 20 W., 28.0' | | | | | |
| 4 2" ELM S. 66 W., 68.7' | | | | | |
| 5 36" W. OAK N. 28 W., 77.9' | | | | | |
| Sunday, March 01, 1992 | T. Tietsema | 20712 | LSC | Certificate of Survey | Fd. 1 1/2" iron rod. |
| Witnesses: | | | | | |
| 2 12" HICKORY S. 53 W., 20.4' | | | | | |
| 3 15" S.W. OAK S. 20 W., 28.0' | | | | | |
| 6 36" BURR OAK N. 20 W., 94.3' | | | | | |
| 7 6" CHERRY S. 41 E., 38.3' | | | | | |


B. Description of corner evidence found and/or method applied in restoring or reestablishing corner:

Fd. 1" iron with cap. Set WCR cap.

C. Description of monument for corner and accessories established to perpetuate locating the position of the corner:

- | | | | | | |
|--|----------------------------------|-------|-----|-------|-------|
| Monday, November 01, 1993 | Orchard, Hiltz & McCliment, Inc. | 21584 | OHM | W. C. | Remon |
| Witnesses: | | | | | |
| 3 24" S.W. OAK S. 27 W., 27.60' TO PK NAIL WITH WCR TAG. | | | | | |
| 5 FD. CENTER OF 36" STUMP N 25 W 79' | | | | | |
| 6 48" BURR OAK N. 13 W., 94.3' TO PK NAIL WITH WCR TAG. | | | | | |
| 8 8" OAK S. 59 E., 53.46' TO PK NAIL WITH WCR TAG. | | | | | |
| 9 8" PINE N. 74 E., 83.54' TO PK NAIL WITH WCR TAG. | | | | | |

We conclude that after careful study of the record documentation and field observations, that this corner is accepted as a careful and faithful perpetuation of the position of the original corner.

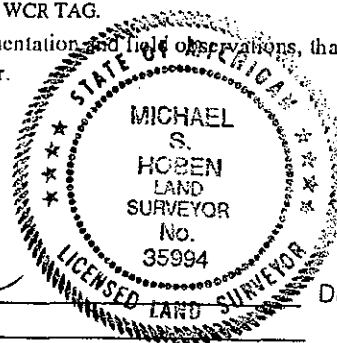

APPROVED
 DATE 4-19-94
 CO. REP. K

Signed by Michael S. Hoben Date Aug 2, 1994
 Drafted by Michael S. Hoben
 Surveyor's Michigan License No. 35994