

REMONUMENTATION

MAY - 1 1995

COMMISSION

LAND CORNER RECORDATION CERTIFICATE
Filing Requirement of Act 74, Mich. P.A. 1970

For corners in
Washtenaw
County

Located in: Lima Twp Corner Code

- 1. Public Land Survey T 2 S R 4 E J-9
2. Property Controlling in Section S T R
3. Miscellaneous Property in Sec. S T R
4. Lot No. Recorded Plat
5. Private Claims

RECORDED
WASHTENAW COUNTY, MI
SEP 27 11 22 AM '94
COUNTY CLERK/REGISTER
PERRY M. HAINES
LIBER 1 PAGE 88Rn
-COPY-
Register of Deeds Stamp and File Number

Grid table with columns A-L and rows 2-13. A dot is present in row 9, column J.

I, Michael S. Hoben in a field survey on Sunday, September 05, 1993 do hereby certify that under requirements of P.A. 74, Michigan P.A. of 1970, the corner points mentioned in lines 1 and 2 above were in conformance with regulations and rules therefore as required in the current manual of survey instructions of the United States Department of the Interior, Bureau of Land Management. or by a decree of a Court of Law and/or that the corner points mentioned in lines 3, 4 and 5 above were in conformance with the rules of the Michigan Board of Land Surveyors or by a Decree of a Court of Law, established, re-established, monumented, re-monumented, recovered, found as expressed below.

NOTE: Not more than 4 corners, all in the same town and range, may be recorded on this certificate.

A. Description of original monument and accessories and/or subsequent restorations:

- Wednesday, January 01, 1817 Wampler G.L.O. Set post.
Witnesses: 13" WHITE OAK S. 31 W., 19 LINKS (12.54') 14" WHITE OAK S. 62 E., 24 LINKS (15.84')
Friday, May 02, 1941 W. J. Armstrong 2444 WCR Grid Book Fd wood stake & iron rod. Set 1 1/2" iron pipe. Stones and brick.
Witnesses: 1 W. OAK 28" DIA. N. 78 E., 89.1' 2 W. OAK 26" DIA. S. 73.5 E., 42.7' 3 W. OAK 12" DIA. S. 43 E., 29.7' 4 B. OAK 29" DIA. S. 28 W., 31.8' 5 B. OAK 12" DIA. S. 32 W., 29.25' 6 B. CHERRY 14" DIA. S. 58 W., 36.2' 7 MAPLE 24" DIA. N. 63 W., 73.0' 8 MAPLE 20" DIA. N. 9.5 W., 32.3'
Thursday, August 01, 1985 T. Tietsema 20712 LSC Certificate of Survey Fd. 1 1/2" iron pipe.
Witnesses: 2 NAIL IN W. OAK 36" DIA. S. 67 E., 42.91' 6 NAIL IN B. OAK 31" DIA. S. 65 W., 35.90' 7 NAIL IN MAPLE 33" DIA. N. 56 W., 71.75' 9 NAIL IN W. OAK 24" DIA. N. 22 W., 43.31' 10 NAIL IN W. OAK 36" DIA. N. 78 W., 25.79' 11 NAIL IN R. OAK 24" DIA. S. 23 W., 52.68'


B. Description of corner evidence found and/or method applied in restoring or reestablishing corner:

Fd. 1 1/2" iron pipe. Set WCR cap on iron.

C. Description of monument for corner and accessories established to perpetuate locating the position of the corner:

- Sunday, September 05, 1993 Orchard, Hiltz & McCliment, Inc. 21584 OHM W. C. Remou
Witnesses: 1 SET PK NAIL WITH WCR TAG IN 48" OAK N. 82 E., 88.24' 2 SET PK NAIL WITH WCR TAG IN 42" OAK S. 73 E., 42.13' 4 FD. STUMP S. 30 W., 31.8' 5 FD. STUMP S. 35 W., 29.3' 6 SET PK NAIL WITH WCR TAG IN 42" OAK S. 65 W., 35.75' 7 SET PK NAIL WITH WCR TAG IN 42" OAK N. 60 W., 71.03' 12 SET PK NAIL WITH WCR TAG IN FENCE POST S. 9 W., 33.12'

We conclude that after careful study of the record documentation and field observations, that this corner is accepted as a careful and faithful perpetuation of the position of the original corner.

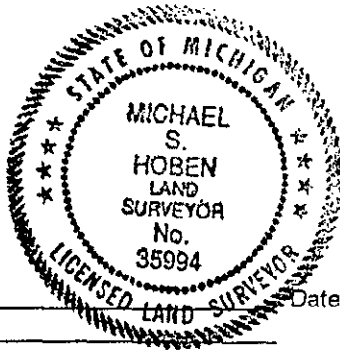

Signed by Michael S. Hoben

Drafted by Michael S. Hoben

Surveyor's Michigan License No. 35994

Date Aug 2 1994

Orchard, Hiltz and McCliment, Inc. 34935 Schoolcraft Road Livonia, MI 48150

APPROVED

DATE 4-19-74

CO. REP. EA