

SUMMARY &
REMONUMENTATION

MAY - 1 1995

COMMISSION

LAND CORNER RECORDATION CERTIFICATE
Filing Requirement of Act 74, Mich. P.A. 1970

For corners in

Washtenaw

County

Located in: Lima Twp Corner Code

1. Public Land Survey

T 2 S R 4 E J-11

T _____ R _____

T _____ R _____

T _____ R _____

2. Property Controlling in Section

S _____ T _____ R _____

S _____ T _____ R _____

3. Miscellaneous Property in Sec.

S _____ T _____ R _____

S _____ T _____ R _____

4. Lot No. _____, Recorded Plat _____

5. Private Claims _____

COPY
REGISTERED
WASHTENAW COUNTY, MI
SEP 21 11 22 AM '94
PEGGY M. HAINES
COUNTY CLERK/REGISTER
1-11
1 PAGE 90RM
-COOP-
Register of Deeds Stamp and File Number

I, Michael S. Hoben in a field survey on Monday, November 01, 1993 do hereby certify that under requirements of P.A. 74, Michigan P.A. of 1970, the corner points mentioned in lines 1 and 2 above were in conformance with regulations and rules therefore as required in the current manual of survey instructions of the United States Department of the Interior, Bureau of Land Management, or by a decree of a Court of Law and/or that the corner points mentioned in lines 3, 4 and 5 above were in conformance with the rules of the Michigan Board of Land Surveyors or by a Decree of a Court of Law, established, re-established, monumented, re-monumented, recovered, found as expressed below.

NOTE: Not more than 4 corners, all in the same town and range, may be recorded on this certificate.

	A	B	C	D	E	F	G	H	I	J	K	L	I
2	6	5	4	3	2	1							
3													
4	7	8	9	10	11	12							
5													
6	18	17	16	15	14	13							
7													
8	19	20	21	22	23	24							
9													
10	30	29	28	27	26	25							
11													
12	31	32	33	34	35	36							
13													

A. Description of original monument and accessories and/or subsequent restorations:

- Wednesday, January 01, 1817 Wampler G.L.O. Set post.
Witnesses:
26" W. OAK S. 17 E., 127 LINKS (83.82')
22" W. OAK N. 65 E., 122 LINKS (80.52')
- Wednesday, May 26, 1937 W. J. Armstrong 2444 WCRC Grid Book Fd. old wood stake. Set 1 1/2" X 38" pipe, stones & bricks.
Witnesses:
1 30" W. OAK N. 31 E., 105.8'
2 30" W. OAK N. 39 E., 79.8'
3 30" W. OAK N. 39 E., 95.8'
4 S.W. COR. PORCH 4. 44 E., 110.8'
5 30" W. OAK N. 72 E., 103.8'
6 10" APPLE S. 37 W., 50.7'
7 5" APPLE N. 72 W., 88.4'
8 6" TWIN CHERRY N. 30 W., 33.7'
- Friday, February 05, 1988 C. A. Eckfeld 33135 CWA L7-P15 Certificate of Survey Fd. 1 1/2" iron pipe (raised with 1/2" iron pipe).
Witnesses:
1 36" W. OAK N. 31 E., 105.8'
2 36" W. OAK N. 39 E., 79.8'
3 36" W. OAK N. 39 E., 95.8'
4 S.W. COR. PORCH N. 44 E., 110.8'
5 36" W. OAK N. 72 E., 103.8'
7 14" APPLE N. 72 W., 88.4'
- Sunday, March 01, 1992 T. Tietsema 20712 LSC Certificate of Survey Fd. 1/2" iron pipe.
Witnesses:
1 36" W. OAK N. 31 E., 105.8'
2 36" W. OAK N. 39 E., 79.8'
3 36" W. OAK N. 39 E., 95.8'
5 36" W. OAK N. 72 E., 103.8'
7 14" APPLE N. 72 W., 88.4'

3. Description of corner evidence found and/or method applied in restoring or reestablishing corner:


1. 3/4" iron pipe. Set WCR cap on iron.

2. Description of monument for corner and accessories established to perpetuate locating the position of the corner:

- Monday, November 01, 1993 Orchard, Hiltz & McCliment, Inc. 21584 OHM W. C. Remon
Witnesses:
2 SET PK NAIL WITH WCR TAG IN 40" W. OAK N. 42 E., 79.15'
5 SET PK NAIL WITH WCR TAG IN 40" W. OAK N. 78 E., 103.42'
7 SET PK NAIL WITH WCR TAG IN 18" APPLE N. 65 W., 88.18'

- COPY -

We conclude that after careful study of the record documentation and field observations, that this corner is accepted as a careful and faithful perpetuation of the position of the original corner.

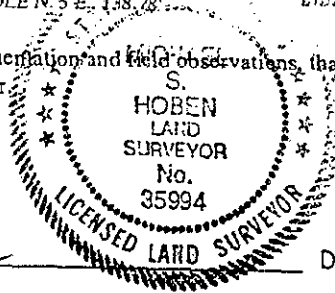

Signed by Michael S. Hoben

Date Aug 2, 1994

Drafted by Michael S. Hoben
Surveyor's Michigan License No. 35994

Orchard, Hiltz and McCliment, Inc. 34935 Schoolcraft Road Livonia, MI 48150

APPROVED

DATE 4-19-94

CO. REP. KA