

**SURVEY &
REMONUMENTATION**

MAY - 1 1995

COMMISSION

**LAND CORNER RECORDATION CERTIFICATE
Filing Requirement of Act 74, Mich. P.A. 1970**

For corners in
Washtenaw
County

Located in: Lima Twp Corner Code

1. Public Land Survey	T <u>2</u> S	R <u>4</u> E	<u>K-9</u>
	T _____	R _____	_____
	T _____	R _____	_____
	T _____	R _____	_____
2. Property Controlling in Section	S _____	T _____	R _____
	S _____	T _____	R _____
3. Miscellaneous Property in Sec.	S _____	T _____	R _____
	S _____	T _____	R _____
4. Lot No. _____, Recorded Plat _____			
5. Private Claims _____			

RECORDED
 WASHTENAW COUNTY, MI
 SEP 21 11 23 AM '94
 PERRY H. HAINES
 COUNTY CLERK/REGISTRAR
 LIBER 1 PAGE 93F
 -COPY-
 Register of Deeds Stamp and File Number

I, Michael S. Hoben in a field survey on Monday, November 01, 1993 do hereby certify that under requirements of P.A. 74, Michigan P.A. of 1970, the corner points mentioned in lines 1 and 2 above were in conformance with regulations and rules therefore as required in the current manual of survey instructions of the United States Department of the Interior, Bureau of Land Management. or by a decree of a Court of Law and/or that the corner points mentioned in lines 3, 4 and 5 above were in conformance with the rules of the Michigan Board of Land Surveyors or by a Decree of a Court of Law, established, re-established, monumented, re-monumented, recovered, found as expressed below.

NOTE: Not more than 4 corners, all in the same town and range, may be recorded on this certificate.

	A	B	C	D	E	F	G	H	I	J	K	L
2	6	5	4	3	2	1						
3												
4	7	8	9	10	11	12						
5												
6	18	17	16	15	14	13						
7												
8	19	20	21	22	23	24						
9												
10	30	29	28	27	26	25						
11												
12	31	32	33	34	35	36						
13												

A. Description of original monument and accessories and/or subsequent restorations:

- | | | | | | |
|---|-----------------|-------|------|-----------------------|--|
| Wednesday, January 01, 1817 | Wampler | | | G.L.O. | After 1816. Set post. |
| Witnesses: | | | | | |
| 25" WHITE OAK S. 89 E., 16 LINKS (10.56') | | | | | |
| 28" WHITE OAK S. 9 W., 132 LINKS (87.12') | | | | | |
| 2 ELM 3" DIA. S. 73 E., 117.85' | | | | | |
| 3 B. CHERRY 8" DIA. S. 19 W., 74.6' | | | | | |
| 4 W. OAK 36" DIA. S. 70 W., 91.0' | | | | | |
| 5 ELM 12" DIA. N. 82 W., 90.0' | | | | | |
| 6 MAPLE 14" DIA. N. 70 W., 69.2' | | | | | |
| 7 ELM 12" DIA. N. 30.5 W., 55.8' | | | | | |
| 8 WALNUT 8" N. 7 W., 134.6' | | | | | |
| Thursday, May 01, 1941 | W. J. Armstrong | 2444 | WCRC | Grid Book | Fd stk stones & bricks. Set 1 1/2" X 40" iron pipe with stones and bricks around the iron. |
| Witnesses: | | | | | |
| 1 W. OAK 28" DIA. N. 79.5 E., 97.7' | | | | | |
| Wednesday, January 17, 1973 | John F. Oliver | 19840 | | L3-PS7 | Fd. 1 1/2" pipe. |
| Witnesses: | | | | | |
| 1 W. OAK 34" DIA. N. 79.5 E., 97.7' | | | | | |
| 3 B. CHERRY 15" DIA. S. 19 W., 74.6' | | | | | |
| 4 W. OAK 40" DIA. S. 70 W., 91.0' | | | | | |
| 8 WALNUT 15" DIA. N. 7 W., 134.6' | | | | | |
| 9 POWER POLE N. 25 E., 55.8' | | | | | |
| 10 POWER POLE S. 10 E., 103.1' | | | | | |
| Wednesday, January 28, 1976 | Norm Fahrner | 17620 | WEC | Certificate of Survey | Fd. 1 1/2" iron pipe. |
| Witnesses: | | | | | |
| 1 W. OAK 34" DIA. N. 79.5 E., 97.7' | | | | | |
| 3 B. CHERRY 15" DIA. S. 19 W., 74.6' | | | | | |
| 4 W. OAK 40" DIA. S. 70 W., 91.0' | | | | | |
| 8 WALNUT 15" DIA. N. 7 W., 134.6' | | | | | |
| 9 POWER POLE N. 25 E., 55.8' | | | | | |
| 10 POWER POLE S. 10 E., 103.1' | | | | | |


3. Description of corner evidence found and/or method applied in restoring or reestablishing corner:

1. 1 1/2" iron pipe & set a WCR atop on iron.
2. Description of monument for corner and accessories established to perpetuate locating the position of the corner:
- | | | | | |
|--|----------------------------------|-------|-----|-------------|
| Monday, November 01, 1993 | Orchard, Hiltz & McCliment, Inc. | 21584 | OHM | W. C. Remon |
| Witnesses: | | | | |
| 1 SET A PK NAIL WITH A WCR TAG IN A 54" OAK N. 83 E., 97.72' | | | | |
| 3 SET A PK NAIL WITH A WCR TAG IN A 40" OAK S. 20 W., 73.86' | | | | |

- 4 SET A PK NAIL WITH A WCR TAG IN A 60" OAK S. 75 W., 89.75'
- 9 SET A PK NAIL WITH A WCR TAG IN A D.E. POLE N. 22 E., 53.75'

LIBER 1 PAGE 94RM
-COPY-

We conclude that after careful study of the record documentation and field observations, that this corner is accepted as a careful and faithful perpetuation of the position of the original corner.

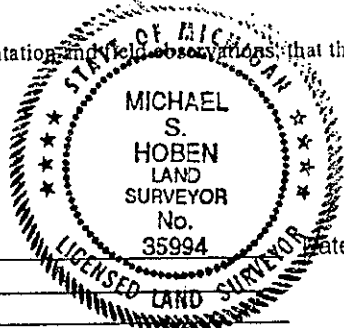

Signed by Michael S. Hoben

Drafted by Michael S. Hoben

Surveyor's Michigan License No. 35994

Date Aug 2, 1994

Orchard, Hiltz and McCliment, Inc. 34935 Schoolcraft Road Livonia, MI 48150

APPROVED

DATE 4-19-94

CO. REP. KA