

REMONUMENTATION

MAY - 1 1995

COMMISSION

LAND CORNER RECORDATION CERTIFICATE
Filing Requirement of Act 74, Mich. P.A. 1970

For corners in

Washtenaw

County

Located in: Lima Twp Corner Code

1. Public Land Survey	T <u>2</u> S	R <u>4</u> E	<u>K-10</u>
	T	R	
	T	R	
	T	R	
2. Property Controlling in Section	S	T	R
	S	T	R
3. Miscellaneous Property In Sec.	S	T	R
	S	T	R
4. Lot No. _____, Recorded Plat _____			
5. Private Claims _____			

COPY
 PEGGY M. HAINES
 COUNTY CLERK/REGISTRAR
 K-10
 SEP 21 11 25 AM '94
 1 PAGE
 95R
 REGISTER OF DEEDS STAMP AND FILE NUMBER

I, Michael S. Hoben in a field survey on Monday, November 01, 1993 do hereby certify that under requirements of P.A. 74, Michigan P.A. of 1970, the corner points mentioned in lines 1 and 2 above were in conformance with regulations and rules therefore as required in the current manual of survey instructions of the United States Department of the Interior, Bureau of Land Management. or by a decree of a Court of Law and/or that the corner points mentioned in lines 3, 4 and 5 above were in conformance with the rules of the Michigan Board of Land Surveyors or by a Decree of a Court of Law, established, re-established, monumented, re-monumented, recovered, found as expressed below.

NOTE: Not more than 4 corners, all in the same town and range, may be recorded on this certificate.

	A	B	C	D	E	F	G	H	I	J	K	L
2	6	5	4	3	2	1						
3												
4	7	8	9	10	11	12						
5												
6	18	17	16	15	14	13						
7												
8	19	20	21	22	23	24						
9												
10	30	29	28	27	26	25						
11												
12	31	32	33	34	35	36						
13												

A. Description of original monument and accessories and/or subsequent restorations:

Wednesday, January 01, 1817	Wampler			G.L.O.	After 1816. Set post.
Witnesses:					
30" WHITE OAK S. 65 E., 16 LINKS (10.56')					
23" WHITE OAK N. 84 W., 24 LINKS (15.84')					
Thursday, April 03, 1941	W. J. Armstrong	2444	WCRC	Grid Book	Fd old wood stake with stones & bricks around it. Set 1 1/2" X 40" iron pipe, stones and bricks.
Witnesses:					
1 20" MAPLE N. 51.5 E., 27.4'					
2 10" HICKORY N. 80 E., 25.25'					
3 6" HICKORY S. 17 W., 84.0'					
4 15" HICKORY N. 76 W., 32.0'					
5 6" B. CHERRY N. 25 W., 56.0'					
Wednesday, March 01, 1978	T. Tietsema	20712	CSA	Certificate of Survey	Fd. iron.
Witnesses:					
2 10" HICKORY N. 80 E., 25.25'					
4 15" HICKORY N. 76 W., 32.0'					
5 6" B. CHERRY N. 25 W., 56.0'					
Tuesday, March 01, 1988	T. Tietsema	20712	LSC	Certificate of Survey	Fd. iron.
Witnesses:					
3 15" HICKORY S. 17 W., 84.0'					
4 20" HICKORY N. 76 W., 32.0'					
6 25" OAK N. 13 E., 88.00'					
7 35" OAK N. 17 W., 110.60'					

B. Description of corner evidence found and/or method applied in restoring or reestablishing corner:

Fd. 1 3/4" iron pipe & set a WCR cap on iron.


C. Description of monument for corner and accessories established to perpetuate locating the position of the corner:

Monday, November 01, 1993	Orchard, Hiltz & McCliment, Inc.	21584	OHM	W. C. Remon
Witnesses:				
4 SET PK NAIL WITH A WCR TAG IN 30" HICKORY N. 74 W., 31.80'				
6 SET PK NAIL WITH A WCR TAG IN 36" OAK N. 10 E., 87.40'				
7 NAIL IN 35" OAK N. 17 W., 111.80'				
8 NAIL IN D.E. POLE N. 25 E., 89.58'				
9 SET PK NAIL WITH WCR TAG IN FENCE POST S. 87 E., 31.03'				
10 SET PK NAIL WITH WCR TAG IN D.E. POLE S. 12 E., 79.44'				

LIBER

1 PAGE 96RM
-COPY-

We conclude that after careful study of the record documentation and field observations, that this corner is stepped as a careful and faithful perpetuation of the position of the original corner.

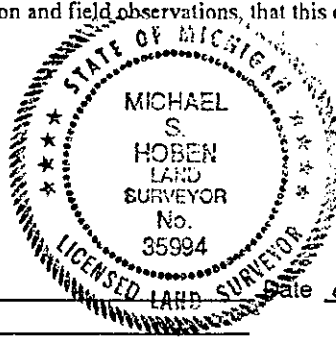

Signed by Michael S. Hoben
 Drafted by Michael S. Hoben
 Surveyor's Michigan License No. 35994

Aug 2, 1994

Orchard, Hiltz and McCliment, Inc. 34935 Schoolcraft Road Livonia, MI 48150

APPROVED
 DATE 4-19-94
 CO. REP. K/A