

Survey &
REMONUMENTATION

MAY - 1 1995

COMMISSION

For corners in
Washenaw
County

LAND CORNER RECORDATION CERTIFICATE
Filing Requirement of Act 74, Mich. P.A. 1970

Located in: Lima Twp Corner Code

1. Public Land Survey	T	2	S	R	4	E	K-11
	T			R			
	T			R			
	T			R			
2. Property Controlling in Section	S		T	R			
	S		T	R			
3. Miscellaneous Property in Sec.	S		T	R			
	S		T	R			
4. Lot No. _____, Recorded Plat _____							
5. Private Claims _____							

RECORDED
 WASHENAW COUNTY, MI
 SEP 21 11 25 AM '94
 K-11
 REGGY M. HAINES
 COUNTY CLERK/REGISTRAR
 LIBER 1 PAGE 97Rr
 -COPY
 Register of Deeds Stamp and File Number

I, Michael S. Hoben in a field survey on Monday, November 01, 1993 do hereby certify that under requirements of P.A. 74, Michigan P.A. of 1970, the corner points mentioned in lines 1 and 2 above were in conformance with regulations and rules therefore as required in the current manual of survey instructions of the United States Department of the Interior, Bureau of Land Management, or by a decree of a Court of Law and/or that the corner points mentioned in lines 3, 4 and 5 above were in conformance with the rules of the Michigan Board of Land Surveyors or by a Decree of a Court of Law, established, re-established, monumented, re-monumented, recovered, found as expressed below.

NOTE: Not more than 4 corners, all in the same town and range, may be recorded on this certificate.

	A	B	C	D	E	F	G	H	I	J	K	L
2	6	5	4	3	2	1						
3												
4	7	8	9	10	11	12						
5												
6	18	17	16	15	14	13						
7												
8	19	20	21	22	23	24						
9												
10	30	29	28	27	26	25						
11												
12	31	32	33	34	35	36						
13												

A. Description of original monument and accessories and/or subsequent restorations:

Wednesday, January 01, 1817	Wampler			G.L.O.	After 1816. Set post.
Witnesses: 15" W. OAK S. 89 W., 76 LINKS (50.16') 16" W. OAK S. 66 E., 23 LINKS (15.18')					
Tuesday, April 12, 1938	W. J. Armstrong	2444	WCRC	Grid Book	Fd. wood stake & set 1 1/2" X 30" iron pipe with stones and bricks.
Witnesses: 1 12" HICKORY N. 73 E., 57.6' 2 12" HICKORY N. 75 E., 76.5' 3 32" W. OAK S. 75 E., 61.0' 4 10" APPLE S. 32 W., 49.4' 5 11" HICKORY S. 65 W., 55.4' 6 2" JUNIPER S. 41 W., 37.9'					
Thursday, November 28, 1974	Howard W. Taft	12032		L3-P55	Fd. 1 1/2" pipe & 4 witnesses. Set 3/4" pipe, raised to existing grade.
Witnesses: 3 40" W. OAK S. 75 E., 61.1' 4 12" APPLE CLUMP S. 30 W., 48.5' 5 16" HICKORY S. 65 W., 55.5' 6 10" JUNIPER S. 41 W., 37.6'					
Wednesday, March 01, 1978	T. Tietsema	20712		Certificate of Survey	Fd. iron.
Witnesses: S. 65 W., 55.15' N. 60 W., 31.98' 3 NAIL INSIDE 30" OAK S. 75 E., 60.68' 5 NAIL IN N. SIDE 14" HICKORY 7 NAIL IN N. SIDE T. POLE					
Tuesday, March 01, 1988	T. Tietsema	20712		Certificate of Survey	Fd. iron.
Witnesses: S. 65 W., 56.40' 2 20" HICKORY N. 75 E., 76.50' 4 10" APPLE CLUMP S. 32 W., 49.90' 5 NAIL IN N. SIDE 25" HICKORY 6 10" JUNIPER S. 41 W., 37.6'					

B. Description of corner evidence found and/or method applied in restoring or reestablishing corner:

Fd. 2" iron pipe & set a WCR cap on iron.


C. Description of monument for corner and accessories established to perpetuate locating the position of the corner:

Monday, November 01, 1993 Orchard, Hiltz & 21584 OHM
McCliment, Inc.

Witnesses:

- 3 SET A PK NAIL WITH WCR TAG IN 48" OAK S. 73 E., 60.46'
- 4 CENTER OF GROUP OF APPLE TREES 50'
- 5 SET A PK NAIL SET A PK NAIL WITH A WCR TAG IN 18" HICKORY S. 71 W., 54.63'.
- 8 SET A PK NAIL WITH A WCR TAG IN D.E. POLE N. 27 E., 69.46'
- 9 SET A PK NAIL WITH WCR TAG IN D.E. POLE S. 18 E., 68.33'

We conclude that after careful study of the record documentation and field observations, that this corner is accepted as a careful and faithful perpetuation of the position of the original corner.

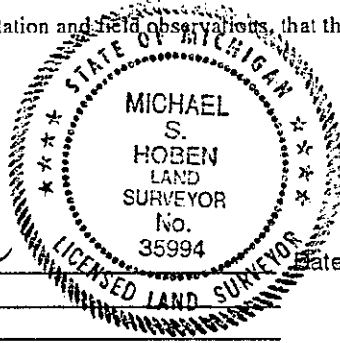

Signed by Michael S. Hoben Date Aug 2, 1994
 Drafted by Michael S. Hoben
 Surveyor's Michigan License No. 35994

Orchard, Hiltz and McCliment, Inc. 34935 Schoolcraft Road Livonia, MI 48150

APPROVED
 DATE 4-19-94
 CO. REP. K