

REMONUMENTATION

MAY - 1 1995
COMMISSION

LAND CORNER RECORDATION CERTIFICATE
Filing Requirement of Act 74, Mich. P.A. 1970

For corners in
Washtenaw
County

Located in: Lima Twp Corner Code

1. Public Land Survey	T	2	S	R	4	E	K-12
	T			R			
	T			R			
	T			R			
2. Property Controlling in Section	S		T	R			
	S		T	R			
3. Miscellaneous Property in Sec.	S		T	R			
	S		T	R			
4. Lot No. _____, Recorded Plat _____							
5. Private Claims _____							

RECORDED
 WASHTEENAW COUNTY, MI
 SEP 21 11 25 AM '94
 PERCY H. HAINES
 COUNTY CLERK/REGISTER
 K-12
 1 PAGE
 99Rn
 -COPY-
 Register of Deeds Stamp and File Number

I, Michael S. Hoben in a field survey on Monday, November 01, 1993 do hereby certify that under requirements of P.A. 74, Michigan P.A. of 1970, the corner points mentioned in lines 1 and 2 above were in conformance with regulations and rules therefore as required in the current manual of survey instructions of the United States Department of the Interior, Bureau of Land Management. or by a decree of a Court of Law and/or that the corner points mentioned in lines 3, 4 and 5 above were in conformance with the rules of the Michigan Board of Land Surveyors or by a Decree of a Court of Law, established, re-established, monumented, re-monumented, recovered, found as expressed below.

NOTE: Not more than 4 corners, all in the same town and range, may be recorded on this certificate.

	A	B	C	D	E	F	G	H	I	J	K	L
2	6	5	4	3	2	1						
3												
4	7	8	9	10	11	12						
5												
6	18	17	16	15	14	13						
7												
8	19	20	21	22	23	24						
9												
10	30	29	28	27	26	25						
11												
12	31	32	33	34	35	36						
13												

A. Description of original monument and accessories and/or subsequent restorations:

- Wednesday, January 01, 1817 Wampler G.L.O. After 1816. Set post.

Witnesses:

9" TWIN OAK S. 86 E., 11 LINKS (7.26')
34" WHITE OAK S. 11 W., 39 LINKS (25.74')
- Tuesday, May 02, 1939 W. J. Armstrong 2444 WCRC Grid Book Fd. old wood stake. Set 1 1/2" X 36" iron pipe with stones and bricks.

Witnesses:

1 2" WALNUT N. 61 E., 25.5'
2 2" ELM N. 87 E., 18.7'
3 10" W. OAK N. 80 W., 35.3'
4 5" HICKORY N. 72 W., 48.0'
5 14" R. OAK N. 50 W., 54.3'
6 10" IRONWOOD N. 30 W., 53.5'
- Monday, October 28, 1974 Howard W. Taft 12032 L3-P56 Fd. 1 1/2" pipe.

Witnesses:

1 12" TRI. WALNUT N. 60 E., 26.0'
3 20" W. OAK N. 80 W., 34.5'
4 12" HICKORY N. 72 W., 48.2'
5 22" R. OAK N. 50 W., 54.3'
- Saturday, January 30, 1988 C. A. Eckfeld 33135 CWA Fd. 1 1/2" pipe.

Witnesses:

1 12" TWIN WALNUT N. 60 E., 25.82'
3 28" W. OAK N. 78 W., 34.64'
4 12" HICKORY N. 72 W., 47.85'
5 20" R. OAK N. 46 W., 54.20'
6 12" OAK S. 21 E., 30.44'

B. Description of corner evidence found and/or method applied in restoring or reestablishing corner:

Fd. a 2" iron pipe & set a wcr cap on iron.


C. Description of monument for corner and accessories established to perpetuate locating the position of the corner:

Monday, November 01, 1993 Orchard, Hiltz & McCliment, Inc. 12584 OHM W. C. Remon

Witnesses:

- 1 SET A PK NAIL WITH A WCR TAG IN A 12" TRI. WALNUT N. 60 E., 25.60'
- 2 SET A PK NAIL WITH A WCR TAG IN 8" ELM N. 87 E., 19.00'
- 3 SET A PK NAIL WITH A WCR TAG IN 36" W. OAK N. 83 W., 33.98'
- 5 SET A PK NAIL WITH A WCR CAP IN 24" R. OAK N. 50 W., 54.22'
- 8 SET A PK NAIL WITH A WCR TAG IN 8" X 8" FENCE POST N. 89 W., 33.13'

We conclude that after careful study of the record documentation and field observations, that this corner is accepted as a careful and faithful perpetuation of the position of the original corner.

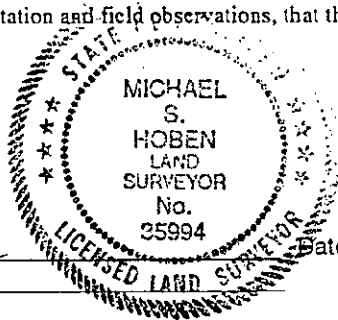

Signed by Michael S. Hoben

Drafted by Michael S. Hoben

Surveyor's Michigan License No. 35994

Date Aug 2, 1994

Orchard, Hiltz and McCliment, Inc. 34935 Schoolcraft Road Livonia, MI 48150

APPROVED
DATE 4-17-94
CO. REP. KA