

SURVEY & REMONUMENTATION

MAY - 1 1995

COMMISSION

For corners in

Washtenaw
County

LAND CORNER RECORDATION CERTIFICATE
Filing Requirement of Act 74, Mich. P.A. 1970

Located in: Lima Twp Corner Code

- | | | |
|---------------------------------------|----------------------------------|------------|
| 1. Public Land Survey | T <u>2</u> S <u>R</u> <u>4</u> E | <u>L-9</u> |
| | T _____ R _____ | _____ |
| | T _____ R _____ | _____ |
| | T _____ R _____ | _____ |
| 2. Property Controlling in Section | S _____ T _____ R _____ | _____ |
| | S _____ T _____ R _____ | _____ |
| 3. Miscellaneous Property in Sec. | S _____ T _____ R _____ | _____ |
| | S _____ T _____ R _____ | _____ |
| 4. Lot No. _____, Recorded Plat _____ | | |
| 5. Private Claims _____ | | |

RECORDED
 WASHTEENAW COUNTY, MI
 SEP 21 11 25 AM '94
 PEABY W. HAINES
 COUNTY CLERK/REGISTER
 L-9
 1 PAGE 103RM
 - COPY -
 Register of Deeds Stamp and File Number

	A	B	C	D	E	F	G	H	I	J	K	L	M
2	6	5	4	3	2	1							
3													
4	7	8	9	10	11	12							
5													
6	18	17	16	15	14	13							
7													
8	19	20	21	22	23	24							
9													
10	30	29	28	27	26	25							
11													
12	31	32	33	34	35	36							
13													

I, Michael S. Hoben in a field survey on Monday, November 01, 1993 do hereby certify that under requirements of P.A. 74, Michigan P.A. of 1970, the corner points mentioned in lines 1 and 2 above were in conformance with regulations and rules therefore as required in the current manual of survey instructions of the United States Department of the Interior, Bureau of Land Management, or by a decree of a Court of Law and/or that the corner points mentioned in lines 3, 4 and 5 above were in conformance with the rules of the Michigan Board of Land Surveyors or by a Decree of a Court of Law, established, re-established, monumented, re-monumented, recovered, found as expressed below.

NOTE: Not more than 4 corners, all in the same town and range, may be recorded on this certificate.

A. Description of original monument and accessories and/or subsequent restorations:

- | | | | | |
|-----------------------------|--|-------|--------|--|
| Wednesday, January 01, 1817 | Wampler | | G.L.O. | After 1816. Set post. |
| Witnesses: | | | | |
| | 24" WHITE OAK N. 24.75 E., 192 LINKS (126.72') | | | |
| Wednesday, April 30, 1941 | W. J. Armstrong | 2444 | WCRC | Grid Book Fd wood stake Set 1 1/2" X 40" iron pipe with stones & bricks. |
| Witnesses: | | | | |
| 1 | B. CHERRY 5" DIA. N. 77.5 E., 88.6' | | | |
| 2 | HICKORY 3" DIA. N. 80 E., 107.7' | | | |
| 3 | B. CHERRY 8" DIA. S. 40 E., 33.4' | | | |
| 4 | B. OAK 3" DIA. N. 74 W., 74.7' | | | |
| Wednesday, January 17, 1973 | John F. Oliver | 19840 | L3,P5 | Fd. 3/4" iron pipe. |
| Witnesses: | | | | |
| 1 | B. CHERRY 10" DIA. N. 77.5 E., 88.6' | | | |
| 2 | HICKORY 6" DIA. N. 80 E., 107.7' | | | |
| 4 | B. OAK 14" DIA. N. 74 W., 74.7' | | | |
| 5 | HICKORY 6" DIA. N. 18 W., 27.7' | | | |


B. Description of corner evidence found and/or method applied in restoring or reestablishing corner:

Fd 2" iron pipe & set WCR cap on iron.

C. Description of monument for corner and accessories established to perpetuate locating the position of the corner:

- | | | | | |
|---------------------------|--|-------|-----|-------------|
| Monday, November 01, 1993 | Orchard, Hiltz & McCliment, Inc. | 21584 | OHM | W. C. Remon |
| Witnesses: | | | | |
| 1 | PK NAIL WITH WCR TAG IN 10" CHERRY N. 80 E., 89.10' | | | |
| 4 | FD. STUMP N. 70 W., 74.7' | | | |
| 5 | PK NAIL WITH WCR TAG IN 13" DIA. TREE N. 12 W., 27.75' | | | |
| 6 | PK NAIL WITH WCR TAG IN 12" DIA. TREE N. 48 E., 37.88' | | | |
| 7 | PK NAIL WITH WCR TAG IN 8" TREE S. 81 W., 166.65' | | | |
| 8 | PK NAIL WITH WCR TAG IN D.E. POLE N. 34 W., 83.70' | | | |

We conclude that after careful study of the record documentation and field observations, that this corner is accepted as a careful and faithful perpetuation of the position of the original corner.

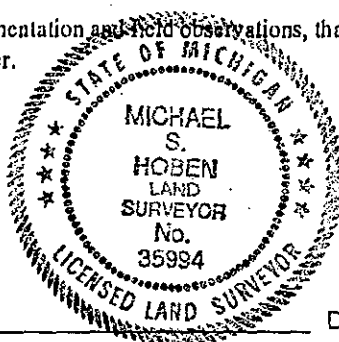

APPROVED
DATE 4-19-94
CO. REP. K

Signed by Michael S. Hoben
 Drafted by Michael S. Hoben
 Surveyor's Michigan License No. 35994

Date Aug 2 1994