

MAY - 1 1995

COMMISSION

LAND CORNER RECORDATION CERTIFICATE
Filing Requirement of Act 74, Mich. P.A. 1970

For corners in
Washtenaw
County

Located in: Lima Twp Corner Code

- | | | | | | | | |
|------------------------------------|---|---|---|---|---|---|------|
| 1. Public Land Survey | T | 2 | S | R | 4 | E | L-13 |
| | T | | | R | | | |
| | T | | | R | | | |
| | T | | | R | | | |
| 2. Property Controlling in Section | S | | | T | | | |
| | S | | | T | | | |
| 3. Miscellaneous Property in Sec. | S | | | T | | | |
| | S | | | T | | | |
4. Lot No. _____, Recorded Plat _____
5. Private Claims _____

RECORDED
 WASHTENAW COUNTY, MI
 SEP 21 11 26 AM '94
 PERRY H. HAINES
 COUNTY CLERK/REGISTRAR
 L-13
 REGISTER OF DEEDS STAMP AND FILE NUMBER
 PAGE 105RM
 COPY

I, Michael S. Hoben in a field survey on Monday, November 01, 1993 do hereby certify that under requirements of P.A. 74, Michigan P.A. of 1970, the corner points mentioned in lines 1 and 2 above were in conformance with regulations and rules therefore as required in the current manual of survey instructions of the United States Department of the Interior, Bureau of Land Management, or by a decree of a Court of Law and/or that the corner points mentioned in lines 3, 4 and 5 above were in conformance with the rules of the Michigan Board of Land Surveyors or by a Decree of a Court of Law, established, re-established, monumented, re-monumented, recovered, found as expressed below.

NOTE: Not more than 4 corners, all in the same town and range, may be recorded on this certificate.

	A	B	C	D	E	F	G	H	I	J	K	L	I
2	6	5	4	3	2	1							
3													
4	7	8	9	10	11	12							
5													
6	18	17	16	15	14	13							
7													
8	19	20	21	22	23	24							
9													
10	30	29	28	27	26	25							
11													
12	31	32	33	34	35	36							
13													

A. Description of original monument and accessories and/or subsequent restorations:

- | | | | | | |
|------------------------------|--|-------|------|-----------|-------------------------------------|
| Monday, January 01, 1816 | B. Hough | | | G.L.O. | 1815 - 1816. Set post. |
| Witnesses: | 14" W. OAK N. 76 E., 48 LINKS (31.68') | | | | |
| | 30" W. OAK N. 68 W., 38 LINKS (25.08') | | | | |
| Sunday, January 01, 1928 | K. Barker | | WCRC | Grid Book | 1928. No mention of what was found. |
| Witnesses: | 1 ASH 10" DIA. NORTHWESTERLY 70.3'
2 ASH 7" DIA. SOUTHERLY 21.75'
3 HICKORY 14" DIA. NORTHEASTERLY 61.1'
4 APPLE 10" DIA. NORTHWESTERLY 60.6'
5 2 RIGHT-OF-WAY PIPES | | | | |
| Monday, October 28, 1974 | Howard W. Taft | 12032 | ΔH | L-3-P.5 | Certificate of Survey Job No. 29146 |
| Witnesses: | 1 ASH 20" DIA. N. 60 W., 71.1'
2 ASH 20" DIA. S. 7 W., 22.2'
6 ASH 10" DIA. S. 45 W., 38.8'
7 ASH 16" DIA. S. 48 W., 41.2' | | | | |
| Saturday, September 17, 1983 | R. A. Campbell | 13028 | WCRC | L-6-P.3 | Witness & reset during construction |
| Witnesses: | 1 SET NAIL S. SIDE ASH 30" DIA. N. 70 W., 71.02'
2 SET NAIL E. SIDE ASH 24" DIA. S. 14 W., 21.84'
6 SET NAIL S. SIDE ASH 15" DIA. S. 56 W., 38.90'
7 ASH 24" DIA. S. 59 W., 41.1'
8 FD. 1" IRON PIPE SOUTH 32.93'
9 GAS PIPELINE MARKER N. 52 E., 48.4'
10 S. EDGE PAVE. SOUTH 11.1'
11 N. EDGE PAVE. NORTH 12.9' | | | | |


B. Description of corner evidence found and/or method applied in restoring or reestablishing corner:

Fd. 1" iron pipe w. cap & set a mon. box with WCR cap on iron.

C. Description of monument for corner and accessories established to perpetuate locating the position of the corner:

- | | | | | |
|---------------------------|--|-------|-----|-------------|
| Monday, November 01, 1993 | Orchard, Hiltz & McCliment, Inc. | 21584 | OHM | W. C. Remon |
| Witnesses: | 2 SET PK NAIL WITH WCR TAG IN 24" OAK S. 15 E., 21.82' | | | |

We conclude that after careful study of the record documentation and field observations, that this corner is accepted as a careful and faithful perpetuation of the position of the original corner.

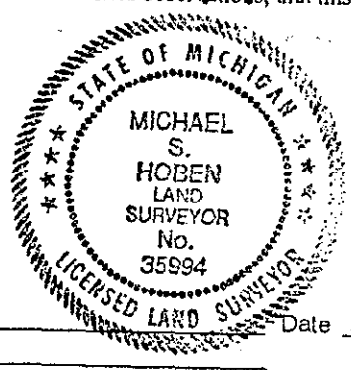

Signed by Michael S. Hoben

Drafted by Michael S. Hoben

Surveyor's Michigan License No. 35994

Orchard, Hiltz and McCliment, Inc. 34935 Schoolcraft Road Livonia, MI 48150

Date Aug 2 1994

APPROVED
DATE 5-3-94
CO. REP. KA