

**SURVEY &
REMONUMENTATION**

MAY - 1 1995

LAND CORNER RECORDATION CERTIFICATE
Filing Requirement of Act 74, Mich. P.A. 1970

COMMISSION
For corners in

Washtenaw
County

Located in: Lima Twp Corner Code

1. Public Land Survey	T	2	S	R	4	E	M-12
	T			R			
	T			R			
	T			R			
2. Property Controlling in Section	S		T	R			
	S		T	R			
3. Miscellaneous Property in Sec.	S		T	R			
	S		T	R			
4. Lot No. _____, Recorded Plat _____							
5. Private Claims _____							

RECORDED
 WASHTEENAW COUNTY, MI
 M-12
 SEP 21 11 26 AM '94
 PEGGY M. HAINES
 COUNTY CLERK/REGISTER
 1 PAGE 112 Rm
 Register of Deeds Stamp and File Number

	A	B	C	D	E	F	G	H	I	J	K	L
2	6	5	4	3	2	1						
3												
4	7	8	9	10	11	12						
5												
6	18	17	16	15	14	13						
7												
8	19	20	21	22	23	24						
9												
10	30	29	28	27	26	25						
11												
12	31	32	33	34	35	36						
13												

I, Michael S. Hoben in a field survey on Monday, November 01, 1993 do hereby certify that under requirements of P.A. 74, Michigan P.A. of 1970, the corner points mentioned in lines 1 and 2 above were in conformance with regulations and rules therefore as required in the current manual of survey instructions of the United States Department of the Interior, Bureau of Land Management, or by a decree of a Court of Law and/or that the corner points mentioned in lines 3, 4 and 5 above were in conformance with the rules of the Michigan Board of Land Surveyors or by a Decree of a Court of Law, established, re-established, monumented, re-monumented, recovered, found as expressed below.

NOTE: Not more than 4 corners, all in the same town and range, may be recorded on this certificate.

A. Description of original monument and accessories and/or subsequent restorations:

- Monday, January 01, 1816 Fletcher G.L.O. 1816. Set post.
Witnesses:
16" W. OAK S. 30 E.. 67 LINKS (44.22')
16" W. OAK S. 13 W.. 33 LINKS (21.78')
- Wednesday, September 27, 1933 W. J. Armstrong 2444 WCRC Grid Book Fd. pile of stones in cen. of rd. Set 1 1/2" X 36" iron pipe stones & bricks.
Witnesses:
1 36" W. OAK N. 26 E.. 78.3'
2 4" B. WALNUT N. 59 E.. 30.5'
4 5" B. WALNUT S. 38.5 W.. 39.5'
5 6" B. WALNUT S. 89.5 W.. 64.3'
6 5" BUTTERNUT S. 37.5 W.. 29.2'
7 ONE R.O.W. PIPE WEST 33.0'
- Wednesday, January 01, 1964 R. B. WCRC Grid Book of Survey 1964. Fd. 1 1/2" iron pipe.
Witnesses:
8 NAIL IN END POST S. 64 W.. 37.90'
9 NAIL IN R.R. TIE END POST S.89 W.. 33.00'
10 TOP CENTER DRIVE CULV. S. 86 W.. 22.00'
11 TOP CENTER DRIVE CULV. S. 47 W.. 31.3'
- Tuesday, September 24, 1974 Howard W. Taft 12032 A H L3-P.3 Certificate of Survey Fd. 3/4" steel bar.
Witnesses:
5 6" B. WALNUT W'LY.. 63.9'
10 TOP CENTER DRIVE CULV. W'LY.. 21.9'
11 TOP CENTER DRIVE CULV. S. 45 W.. 31.5'
12 12" WALNUT W'LY 83.1'
13 W 1/4 POST SEC.31, SCIO TWP. N'LY 52.27'

B. Description of corner evidence found and/or method applied in restoring or reestablishing corner:

Fd. 1 1/2" iron pipe in pave. Set mon. box and 2" iron pipe with WCR cap on iron.

C. Description of monument for corner and accessories established to perpetuate locating the position of the corner:

- Monday, November 01, 1993 Orchard, Hiltz & McCliment, Inc. 21584 OHM W. C. Remon
Witnesses:
5 SET PK NAIL WITH WCR TAG IN 12" B. WALNUT N. 88 E.. 63.87'.
13 FD. IRON (W 1/4 POST SEC.31). SCIO TWP. N'LY 52.27'
14 SET PK NAIL WISET PK NAIL WITH WCR TAG 8" X 8" FENCE POST N.37 E.. 61.85'.
15 SET PK NAIL WITH WCR TAG 8" TREE N. 79 E.. 26.17'.
16 SET PK NAIL WITH WCR TAG ON TWIN 8" TREE S21 E.. 74.50'.


17 SET PK NAIL ON FENCE POST N.88 E.. 34.00'

LIBER

1 PAGE 113RM M-12

Page 2

We conclude that after careful study of the record documentation and field observations, that this corner is accepted as the best available evidence of the position of the original corner.

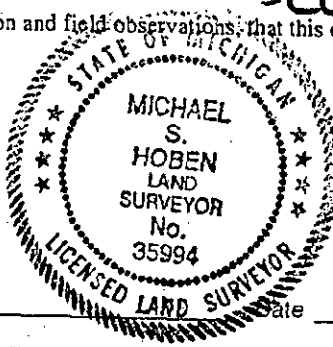

-COPY-

Signed by

Michael S. Hoben

Drafted by

Michael S. Hoben

Surveyor's Michigan License No. 35994

Date

Aug 2, 1994

Orchard, Hiltz and McCliment, Inc. 34935 Schoolcraft Road Livonia, MI 48150

APPROVED

DATE 5-31-94

CO. REP. KA