

RFI

2000

LAND CORNER RECORDATION CERTIFICATE
Filing Requirement of Act 74, Mich. P.A. 1970

SECTION

For corners in

Washtenaw (County) Located In: Corner Code #

- 1. Public Land Survey T 2S R 5E L-3
- 2. Property Controlling in Section S T R
- 3. Miscellaneous Property in Section S T R
- 4. Lot No. , Recorded Plat
- 5. Private Claims

5094719
Page: 1 of 2
02/07/2000 02:55P
L-2 P-310
Peggy M. Haines - Washtenaw Co. CORREM

Register of Deed Stamp & File Number

	A	B	C	D	E	F	G	H	I	J	K	L	M
1													
2	6		5		4		3		2		1		
3									⊙				
4	7		8		9		10		11		12		
5													
6	18		17		16		15		14		13		
7													
8	19		20		21		22		23		24		
9													
10	30		29		28		27		26		25		
11													
12	31		32		33		34		35		36		
13													

I, Thomas L. Sutherland, in a field survey on 11-17-1999 do hereby state that under requirements of P.A. 74, Michigan P.A. of 1970, the corner points mentioned in lines 1 and 2 above were in conformance with regulations and rules therefore as required in the current manual of survey instructions of the United States Department of the Interior, Bureau of Land Management or by a decree of a Court of Law and/or that the corner points mentioned in lines 3, 4 and 5 above were in conformance with the rules of the Michigan Board of Land Surveyors or by a Decree of a Court of Law; established, re-established, monumented, recovered, found as expressed below:

NOTE: Not more than 2 corners, all in the same town and range, may be recorded on this certificate.

- A. Description of original monument and accessories and/or subsequent resortation:
 - G.L.O. 1819, Field Notes
 - 1) 9" B.O. N39°W 151 Links
 - 2) 20" W.O. N75°E 246 Links

Continued on Back

- B. Description of corner evidence found and/or method applied in restoring or re-establishing corner:

Found 1/2" iron rod 6" below gravel surface inside 1/2" iron pipe 11" below surface inside 1" iron pipe 17" below surface imbedded in rocks 22" below surface. Set 1" x 11" iron pipe with aluminum remonumentation cap stamped 24620 over existing 1/2' rod and 1/2' pipe 6" below gravel surface.


- C. Description of monument for corner and accessories established to perpetuate locating the position of the corner:

- 1" x 11" iron pipe with aluminum remonumentation cap stamped 24620 over existing 1/2" rod and 1/2" iron pipe on top of 1" iron pipe surrounded by rocks.
- 5) 24" Walnut S60°E 37.45 to remon tag on SW Side
- 8) NE Corner Barn S60°W 29.55 to stone footing
- 9) SE Corner Barn S30°W 56.55 to concrete block footing
- 10) Utility pole S75°W 22.30 to remon tag on N'y Side
- 11) 22" Maple N20°W 55.20 to remon tag on E'y Side
- 12) 1/2" Iron Pipe (Road P.C.) South 15.68
- 13) 8" Poison Ivy covered Walnut N67°W 29.49 to remon tag on NE Side

I conclude after careful study of the record documentation and field observation, that this corner is accepted as the best available evidence of the position of the original corner.

Signed by: Thomas L. Sutherland THOMAS L. SUTHERLAND

Surveyor's Michigan License No. 24620 No. 24620

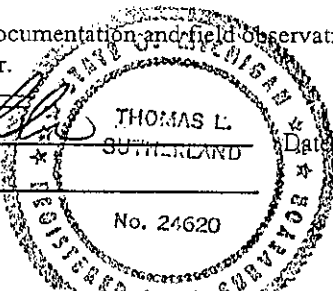

APPROVED
DATE 12/13/99
CO. REP. KA

12/17/99

SECTION



5094719

Page: 2 of 2
02/07/2000 02:55P

Peggy M. Haines - Washtenaw Co. CORREM L-2 P-311

A. Continued:

H.H. Atwell #322, No Date, Grid Book

Iron Pipe

- 3) Forked Elm N45°E 49.3
- 4) 16" Elm N60°E 35.2
- 5) 15" Walnut S60°E 37.6
- 6) 15" Elm S45°E 61.4
- 7) 16" Elm N60°E 67.8

Babson, 1930, Grid Book

- 8) NE Cor. Barn 29.6
- 9) SE Cor. Barn 46.4

Atwell-Hicks, J. Snyder # 13352, 5/6/71
Survey 507-1

- 3) Forked Elm Stump N45°E 49.3
- 4) Forked Elm Stump N80°E 35.2
- 5) Walnut S60°E 37.6
- 8) NE Cor. Barn S80°W 29.6
- 9) SE Cor. Barn S35°W 56.7

Atwell-Hicks, R. Jagow # 6998, 8/23/71 L.C.R.C. Liber 1,
Page 159

Iron Pipe - Left as Found

- 3) Elm Stump N45°E 49.3
- 4) Elm Stump N80°E 35.2
- 5) 24" Walnut S60°E 37.6
- 8) NE Cor. Barn S80°W 29.6
- 9) SE Cor. Barn S35°W 56.7

Roskelly and Jekabson, R. Roskelly # 18663, 12/12/75,
Survey
Iron

- 5) Nail in 24" Walnut N60°E 37.06
- 8) SE Cor. of barn S30°W 56.68
- 9) NE Cor. of barn S60°W 29.62
- 10) Nail in D.E. Polk S70°W 22.78
- 11) Nail in 15" Maple N20°W 54.90

Atwell-Hicks, R. Jagow # 6998, 8/31/76, L.C.R.C. Liber 4,
Page 151

½' Iron Pipe

- 5) 18" Walnut S60°E 37.6
- 11) 16" Maple N40°W 55.0
- 8) NE Cor. Barn S80°W 29.6
- 9) SE Cor. Barn S35°W 56.7
- 13) I.P. Which is P.C. of curve South 15.7

Washtenaw Engineering, N.N. Fahrner # 17620,
11/8/77, L.C.R.C.
Liber 4, Page 363; 11/9/77 Survey R-4093; 8/19/86,
Survey R-5486;
T.L. Sutherland #24620, 8/14/91, Survey R-6272;
1/3/95, Survey R-6855
½" Iron Pipe

- 3) Elm Stump N45°E 49.3
- 4) Elm Stump N60E 35.2
- 5) 22" Walnut S60°E 37.05 to nail
- 6) Elm Stump S45°E 61.4
- 8) NE Cor. Barn S55°W 29.6
- 9) SE Cor. Barn S30°W 56.7
- 10) 14" Maple N15°W 54.91 to nail

Atwell-Hicks, 12/17/86, Survey 507-149

½" Iron Rod

- 12) ¼" Iron Pipe South 15.70
- 13) 1" Iron Pipe S65°E 36.56
- 11) 18" Maple N20°W 55.3
- 10) SE Cor Aluminum Sided Barn S22°W 56.57

Washtenaw Engineering, H.L. O'Donnell #28419, 9/12/89,
Survey R-6006; 11/15/89, Survey R-6045

½" Iron Pipe

- 5) 22" Walnut S60°E 37.05 to nail
- 8) NE Corner Barn S55°W 29.6
- 9) SE Corner Barn S30°W 56.7
- 11) 14" Maple N15°W 54.91 to nail