

REF

2000

LAND CORNER RECORDATION CERTIFICATE
Filing Requirement of Act 74, Mich. P.A. 1970

SECTION

For corners in

Washtenaw
(County)

Located In:

Corner Code #

1. Public Land Survey

T 2S R 5E L-4

T ___ R ___

T ___ R ___

T ___ R ___



5094720
Page: 1 of 2
02/07/2000 02:55P
L-2 P-312

2. Property Controlling
in Section

S ___

T ___ R ___

S ___

T ___ R ___

3. Miscellaneous
Property in Section

S ___

T ___ R ___

S ___

T ___ R ___

Peggy M. Haines - Washtenaw Co. CORREM

Register of Deed Stamp & File Number

4. Lot No. _____, Recorded Plat _____

5. Private Claims _____

	A	B	C	D	E	F	G	H	I	J	K	L	M
1													
2	6		5		4		3		2		1		
3													
4	7		8		9		10		11		12		
5													
6	18		17		16		15		14		13		
7													
8	19		20		21		22		23		24		
9													
10	30		29		28		27		26		25		
11													
12	31		32		33		34		35		36		

I, Thomas L. Sutherland, in a field survey on 11-17-1999 do hereby state that under requirements of P.A. 74, Michigan P.A. of 1970, the corner points mentioned in lines 1 and 2 above were in conformance with regulations and rules therefore as required in the current manual of survey instructions of the United States Department of the Interior, Bureau of Land Management or by a decree of a Court of Law and/or that the corner points mentioned in lines 3, 4 and 5 above were in conformance with the rules of the Michigan Board of Land Surveyors or by a Decree of a Court of Law; established, re-established, monumented, recovered, found as expressed below:

NOTE: Not more than 2 corners, all in the same town and range, may be recorded on this certificate.

A. Description of original monument and accessories and/or subsequent resortation: 13

G.L.O. 1819, Field Notes

- 1) 18" Hickory S8°E 42 Links
- 2) 40" W.O. N29°W 103 Links

Continued on Back

B. Description of corner evidence found and/or method applied in restoring or re-establishing corner:

Found 1/2" x 18" iron pipe (bent badly and NW of actual corner) next to 1" x 24" iron pipe (leaning NW'ly). Bottom of 1" x 24" pipe was next to a plow point 24" below gravel surface and checked reasonably well with remaining witnesses. Reset 1" x 24" iron pipe with aluminum remonumentation cap stamped 24620 6" below gravel surface. Corner is 1" East of Westerly edge of gravel.

C. Description of monument for corner and accessories established to perpetuate locating the position of the corner:

1" x 24" iron pipe with aluminum remonumentation cap stamped 24620 6" below gravel surface and 1" East of West edge of gravel.

- 3) 20" Hickory N10°W 74.61 to remon tag on E'ly Side
- 4) 24" Hickory N35°E 69.68 to remon tag on W'ly Side
- 6) 3" Steel post S85°W 24.57
- 8) 14" Walnut S40°E 46.51 to remon tag on SW Side
- 9) 18" Walnut S35°W 48.87 to remon tag on SE Side
- 10) 3/4" Iron Pipe West 33.00
- 11) Utility Pole N40°W 41.07 to P.K. on NE'ly Side
- 12) 8" Walnut N75°E 33.67 to remon tag on NE'ly Side

I conclude after careful study of the record documentation and field observation, that this corner is accepted as the best available evidence of the position of the original corner.

Signed by:


Thomas L. Sutherland

THOMAS L. SUTHERLAND

Date

12/17/99

Surveyor's Michigan License No. 24620

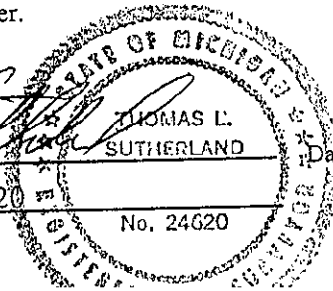

No. 24620

APPROVED
DATE 12/17/99
CO. REP. KA

A. Continued

H.H. Atwell #322, A-H Composite Drawing

- 3) 14" Hickory N20°W 75.3
- 4) 12" Hickory N30°W 70.0
- 5) 10" W. Cherry N50°E 30.2
- 6) 2" Iron Fence Post West 24.8

Grid Book (Handwritten) No Date

- 1" x 18" Iron Pipe
- 3) 16" Hickory N' Wly 75.6
- 4) 12" Hickory NE'ly 70.4
- 5) 10" W. Cherry NE'ly 30.2
- 7) 12" Elm NE'ly 96.3
- 8) 4" Walnut SE'ly 46.0

Atwell Hicks, J.L. Snyder #13352

Surveys 507-1 and 507-1A

- 3) 16" Hickory NW 75.6
- 4) 12" Hickory NE 70.4
- 8) 10" Walnut SE 46.0

Atwell Hicks, R.J. Jagow #6998

8/18/71 Surveys 507-2 and 507-4; 8/23/71

L.C.R.C. Liber 1, Page 155; 9/21/71,

Survey 507-3

- 1" x 18" Iron Pipe
- 3) 24" Hickory N40°W 75.6
- 4) 20" Hickory N40°E 70.4
- 8) 12" Walnut S40°E 46.0
- 9) 10" Walnut S40°W 49.0

Washtenaw Engineering, N.N. Fahrner #17620,
 3/25/74, Survey R-3253; 4/27/77, Survey R-3919;
 11/9/77, Survey R-4039; 8/19/86, Survey R-5486;
 H.L. O'Donnell #28419, 9/12/89, Survey R-6006;
 11/15/89, Survey R-6045; T.L. Sutherland #24620,
 8/14/91, Survey R-6272; 1/3/95, Survey
 R-6855

- ½" Iron Pipe
- 3) 16" Hickory N'Wly 74.6
- 4) 14" Hickory N'Ely 69.9
- 8) 8" Walnut SE'ly 46.6
- 6) 3" Steel post N85°E 24.5

Roskelly & Jekabson, R.P. Roskelly #18663,

12/12/75, Survey 75-12-65,

Iron

- 4) Nail and tag in 18" Hickory N30°E 69.95
- 8) Nail in 12" Walnut S40°E 46.27
- 3) Nail and tag in 18" Hickory N10°W 74.63

C. Wilson & Associates

C.C. Wilson #13604,

1/5/79, Survey 78287

- 3) 24" Hickory N40°W 75.6
- 4) 20" Hickory N40°E 70.4
- 8) 12" Walnut S40°E 46.0
- 9) 10 Walnut S40°W 49.0

Atwell Hicks, P.V. Schwimmer #24618,

4/12/79, L.C.R.C. Liber 5, Page 185

1" Iron Pipe

- 3) 24" Hickory N40°W 75.6
- 4) 20" Hickory N40°E 70.4
- 8) 12" Walnut S40°E 46.0
- 9) 10" Walnut S40°W 49.0
- 10) Right-Of-Way I.P. W'ly 33.0

C. Wilson and Associates, C.C. Wilson #13604,

8/12/85, Survey 85105


1" Iron Pipe

- 3) 24" Hickory N40°W 75.6
- 4) 20" Hickory N40°E 70.4
- 8) 12" Walnut S40°E 46.0
- 9) 10" Walnut S40°W 49.0
- 10) Iron Pipe W'ly 33.0

Atwell-Hicks, 12/17/86, Survey 507-149

½" Pinch Top Iron

- 8) 14" Walnut S40°E 47.2
- 9) 14" Walnut S20°W 49.2
- 11) Power Pole N40°W 41.9
- 3) 20" Shag. Hickory N20°W 74.6
- 4) 20" Shag. Hickory N25°E 70.0

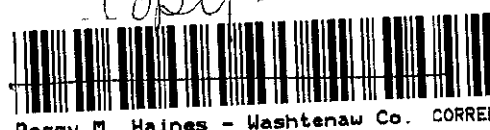

5094720
 Page: 2 of 2
 02/07/2000 02:55P
 L-2 P-313

Peggy M. Haines - Washtenaw Co. CORREM

REA 8/18/71

2000

SECTION