

REF

2000

LAND CORNER RECORDATION CERTIFICATE
Filing Requirement of Act 74, Mich. P.A. 1970

SECTION

For corners in

Washtenaw
(County)

Located In:

Corner Code #

- 1. Public Land Survey T 2S R 5E I-5 Cooy-
- T ___ R ___
- T ___ R ___
- T ___ R ___
- 2. Property Controlling S ___ T ___ R ___
- in Section S ___ T ___ R ___
- 3. Miscellaneous S ___ T ___ R ___
- Property in Section S ___ T ___ R ___
- 4. Lot No. _____, Recorded Plat _____
- 5. Private Claims _____



5094721
Page: 1 of 2
02/07/2000 02:55P
L-2 P-314

Peggy M. Haines - Washtenaw Co. CORREM

Register of Deed Stamp & File Number

I, Thomas L. Sutherland, in a field survey on 11/15/99 do hereby state that under requirements of P.A. 74, Michigan P.A. of 1970, the corner points mentioned in lines 1 and 2 above were in conformance with regulations and rules therefore as required in the current manual of survey instructions of the United States Department of the Interior, Bureau of Land Management or by a decree of a Court of Law and/or that the corner points mentioned in lines 3, 4 and 5 above were in conformance with the rules of the Michigan Board of Land Surveyors or by a Decree of a Court of Law; established, re-established, monumented, recovered, found as expressed below:

	A	B	C	D	E	F	G	H	I	J	K	L	M
1													
2		6		5		4		3		2		1	
3													
4		7		8		9		10		11		12	
5													
6		18		17		16		15		14		13	
7													
8		19		20		21		22		23		24	
9													
10		30		29		28		27		26		25	
11													
12		31		32		33		34		35		36	
13													

NOTE: Not more than 2 corners, all in the same town and range, may be recorded on this certificate.

- A. Description of original monument and accessories and/or subsequent resortation:
 - G.L.O., 1819, Field Notes
 - 1) 26" W.O. S25°W 5 Links
 - 2) 20" W.O. N45°E 12 Links

Continued on Back

- B. Description of corner evidence found and/or method applied in restoring or re-establishing corner:


Found 1/2" threaded rod 4" below gravel surface over 1/2" x 20" iron pipe. Removed existing pipe and rod and set 1" x 24" pipe with aluminum remonumentation cap stamped 24620 6" below gravel surface.

- C. Description of monument for corner and accessories established to perpetuate locating the position of the corner:

- 1" x 24" iron pipe with aluminum remonumentation cap stamped 24620 6" below gravel surface.
- 3) 20" Walnut S75°E 31.62 to remon tag on S'ly side
- 8) 30" Ash N30°E 58.87 to remon tag on W'ly side
- 9) 19" Oak S45°E 70.64 to remon tag on SW side
- 11) 12" Oak N15°W 64.72 to remon tag on W'ly side
- 12) Power pole (DE64-40G5) West 25.41 to PK on N. Side
- 13) Twin 11"-13" Ash East 45.79 to remon tag on N. Side
- 16) MBT Pole S20°E 62.08 to PK on W'ly side

I conclude after careful study of the record documentation and field observation, that this corner is accepted as the best available evidence of the position of the original corner.

Signed by: Thomas L. Sutherland
Surveyor's Michigan License No. 24620

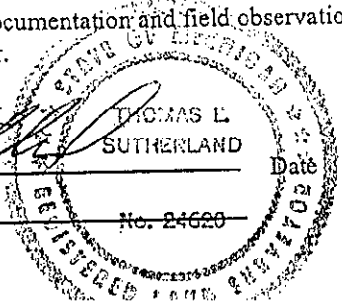

APPROVED
DATE 12/13/99
CO. REP. Ky

12/17/99

Copy



5094721
Page: 2 of 2
02/07/2000 02:55P
L-2 P-315

A. Continued

H.H. Atwell #322, No Date, Grid Book
Iron Pipe

- 3) 12" B. Walnut S60°E 31.6
- 4) 4" Ash SE 21.8
- 5) 7" Ash NW 24.6
- 6) 7" Elm 27.3

SEARCHED
REF
INDEXED
MAR 2000
SECTION

Detroit Edison, 12/18/61, Grid Book
(Handwritten)

- 6) 28" Elm N40°E 26.83 PK Nail
- 7) 3/4" Iron West 33.00 PK Nail
- 3) 24" Box Alder S70°E 31.13 PK Nail
- 5) 28" Black Walnut N45°W 24.35 PK Nail

Atwell-Hicks, R.J. Jagow #3998, 8/18/71, Survey 507-2;
8/18/71, Survey 507-4; 8/23/71, L.C.R.C. Liber 1,
Page 165; 9/21/71, Survey 507-3

Iron Pipe

- 3) 24" Walnut S70°E 31.8
- 5) Stump N50°W 24.6
- 8) 22" Tree N30°E 58.8
- 9) 16" Oak S50°E 70.5
- 10) 24" Oak S30°E 71.9

Washtenaw Engineering, N.N. Fahrner #17620, 3/25/75,
Survey R-3253; 4/27/77, Survey R-3919; 11/9/77, Survey
R-4039; 8/19/86, Survey R-5486; 6/17/97, Survey R-7411

1/2" Iron Pipe

- 7) 3/4" Iron Pipe West 33.00
- 3) 24" Walnut S75°E 31.1
- 8) 24" Ash N25°E 58.4
- 11) 10" Oak N15°W 64.6
- 12) Power Pole (DE-40G5) West 25.5

Atwell-Hicks, H.W. Taft #12032, 2/16/77, Survey 506-50
1/2" Iron Pipe

- 8) 16" Ash N20°E 58.3
- 13) 8" Forked Ash N85°E 46.0
- 3) 18" Walnut S80°E 31.7
- 9) 14" White Oak S45°E 70.7

C. Wilson and Associates, C.C. Wilson #13607, 1/5/79,
Survey 78287; 8/12/85, Survey 85105

Iron Pipe

- 3) 24" Walnut S70°E 31.8
- 5) Stump N50°W 24.6
- 8) 22" Tree N30°E 58.8
- 9) 16" Oak S50°E 70.5
- 10) 24" Oak S30°E 71.9

Land Surveying Consultants, R.T. Tietsiema # 20712,
8/87, Survey 13987-2S5E15

Found Iron Centerline W. Delhi Road

- 14) 12" Elm S75°W 33.56 to Nail
- 15) 9" Box Elder S11°E 52.22 to Nail
- 3) 14" Locust S70°E 31.44 to Nail