

REF

2000

LAND CORNER RECORDATION CERTIFICATE  
Filing Requirement of Act 74, Mich. P.A. 1970

SECTION

For corners in

Washtenaw  
(County)

Located In:

Corner Code #

1. Public Land Survey

T 2S R 5E


1-6

Copy -

T \_\_\_ R \_\_\_

T \_\_\_ R \_\_\_

T \_\_\_ R \_\_\_

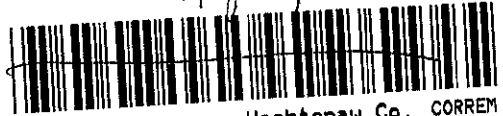

5094722  
Page: 1 of 2  
02/07/2000 02:55P

2. Property Controlling  
in Section

S \_\_\_

T \_\_\_ R \_\_\_

S \_\_\_

T \_\_\_ R \_\_\_

3. Miscellaneous

S \_\_\_

T \_\_\_ R \_\_\_

Property in Section

S \_\_\_

T \_\_\_ R \_\_\_

Peggy M. Haines - Washtenaw Co. CORREM L-2 P-316

Register of Deed Stamp & File Nur

4. Lot No. \_\_\_\_\_, Recorded Plat \_\_\_\_\_

5. Private Claims \_\_\_\_\_

	A	B	C	D	E	F	G	H	I	J	K	L
1												
2		6		5		4		3		2		1
3												
4		7		8		9		10		11		12
5												
6		18		17		16		15	14			13
7												
8		19		20		21		22		23		24
9												
10		30		29		28		27		26		25
11												
12		31		32		33		34		35		36
13												

I, Thomas L. Sutherland, in a field survey on 11/16/99 do hereby state that under requirements of P.A. 74, Michigan P.A. of 1970, the corner points mentioned in lines 1 and 2 above were in conformance with regulations and rules therefore as required in the current manual of survey instructions of the United States Department of the Interior, Bureau of Land Management or by a decree of a Court of Law and/or that the corner points mentioned in lines 3, 4 and 5 above were in conformance with the rules of the Michigan Board of Land Surveyors or by a Decree of a Court of Law; established, re-established, monumented, recovered, found as expressed below:

NOTE: Not more than 2 corners, all in the same town and range, may be recorded on this certificate.

A. Description of original monument and accessories and/or subsequent resortation:

G.L.O., 1819, Field Notes

1) 11 W.O. S63°W 81 Links

2) 11" W.O. N39°E 31 Links

Continued on Back

B. Description of corner evidence found and/or method applied in restoring or re-establishing corner:

Found 1"x30" Iron pipe 12" below ground surface. Removed and found nothing else. Set 1"x24" iron pipe with aluminum remonumentation cap stamped 24620 7" below surface.

C. Description of monument for corner and accessories established to perpetuate locating the position of the corner:

1" x 24" iron pipe with aluminum remonumentation cap stamped 24620 7" below surface.

3) 14" Hickory N45°E 4.81 to remon tag on SE side

6) 60" Oak N5°W 43.13 to remon tag on W'ly side

7) Utility Pole S10°W 20.34 to remon tag on E'ly side

8) 15" Stump S13°E 59.20 to center

9) 18" Oak S45°W 60.00 to remon tag on SE Side

13) 10" Oak East 14.87 to remon tag on S. Side


I conclude after careful study of the record documentation and field observation, that this corner is accepted as the best available evidence of the position of the original corner.

Signed by:

*Thomas L. Sutherland*  
THOMAS L. SUTHERLAND  
Date: \_\_\_\_\_

Surveyor's Michigan License No. 24620

No. 24620

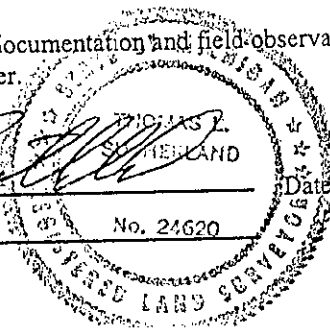

12/17/99

APPROVED  
DATE 12/13  
CO. REP. *[Signature]*

-Copy-

A. Continued



5094722  
Page: 2 of 2  
02/07/2000 02:55P

Peggy M. Haines - Washtenaw Co. CORREM L-2 P-317

H.H. Atwell #322, No Date, Grid Book  
Iron Pipe

- 3) 7" Hickory N. E. 5.1
- 4) 6" Elm E'ly 11.3
- 5) 7" Hickory E'ly 32.8
- 6) 36" W. Oak N'ly 42.3

RECORDED SECTION

Washtenaw Engineering, N.N. Fahrner #17620, 6/17/74,  
Survey R-3329

2000

- 1" Iron Pipe
- 3) 10" Hickory N58°E 5.1
- 6) 40" Oak N13°W 42.3
- 7) Utility Pole S13°W 20.3

SECTION

Atwell-Hicks, P.V. Schwimmer #24618, 2/6/80, Survey  
506-78

3/4" Iron Pipe in Corner of Fence Line

- 6) 46" Oak N4°W 43.0
- 3) 14" Hickory N40°E 5.2
- 8) 10" Maple S13°E 59.3
- 9) 10" Oak S35°W 60.2
- 10) 10" Maple S38°W 67.7

Land Surveying Consultants, R.T. Tietsema #20712, 8/87,  
Survey 13987-2S5E15

Iron

- 11) Dble. Trunk Cherry N80°W 50.88 to Nail
- 6) 72" Maple N25°E 42.44 to Nail
- 7) Power pole S06°W 19.88 to Nail

Land Surveying Consultants, R.T. Tietsema #20712,  
5/98, Survey 02198-2S5E 14/15;

6/98 Survey 02198-2S5E 14/15

- 1" Iron Pipe 1.2 below ground
- 6) 72" Oak N25°E 42.44
- 7) Power Pole S06°E 19.98
- 11) Dbl Cherry N80°W 50.88
- 12) R.R. Tie Fnc. Post N'Ely 0.30